


T.10S.,R.6W.,W.M.

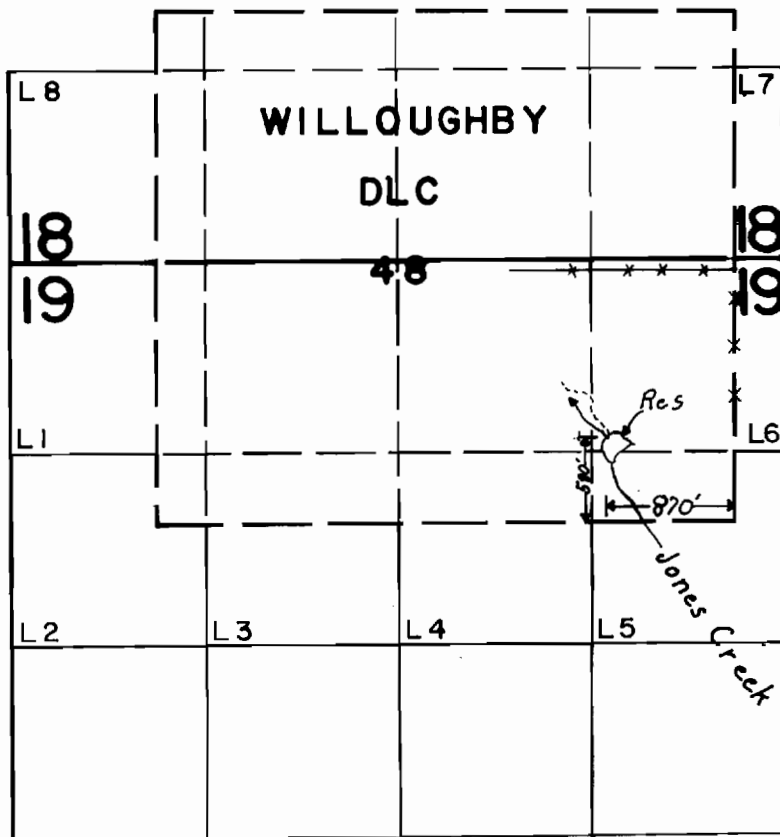

Application No. 49053 Permit No. 36751
~~R-49052~~ ~~R-5961~~
IN NAME OF

STEVE & LAVONDA LOWTHER

Surveyed MAR 30 1976, by C.R. KING