


T.29S. R.12W. W.M.

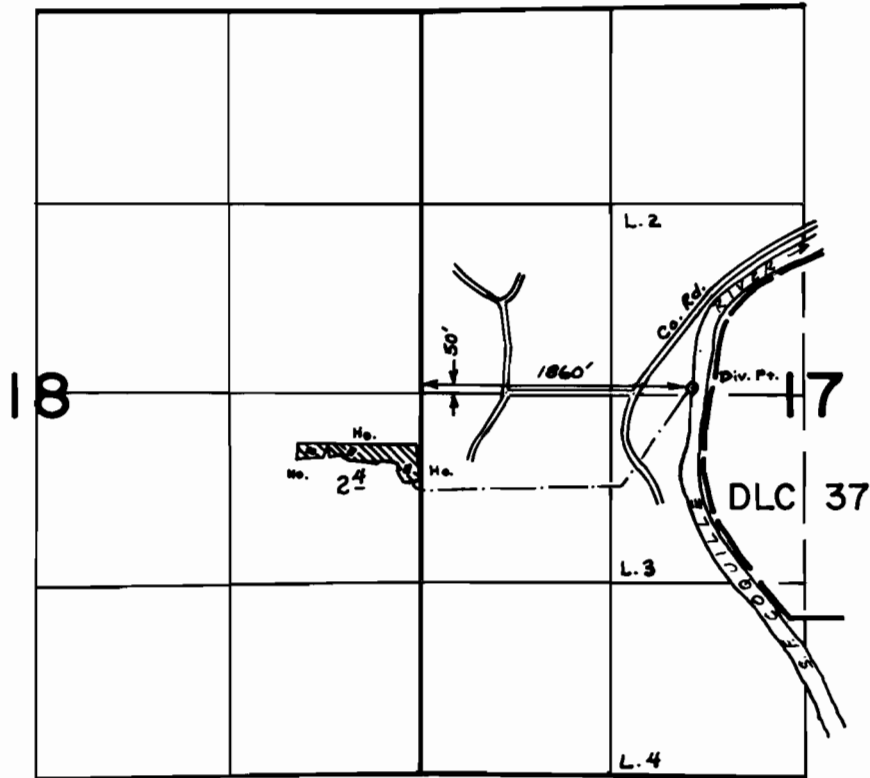

SCALE: 4" = 1 mile

**FINAL PROOF SURVEY
UNDER**

**Application No. 48404 Permit No. 35257
IN NAME OF**

RICHARD J. CHIESA, ROBERT W. BREITKREUTZ, & CHARLES W. SIXBERRY

Surveyed August 10, 1978, by D.W. Sparks