


T.26S. R.12W. W.M.

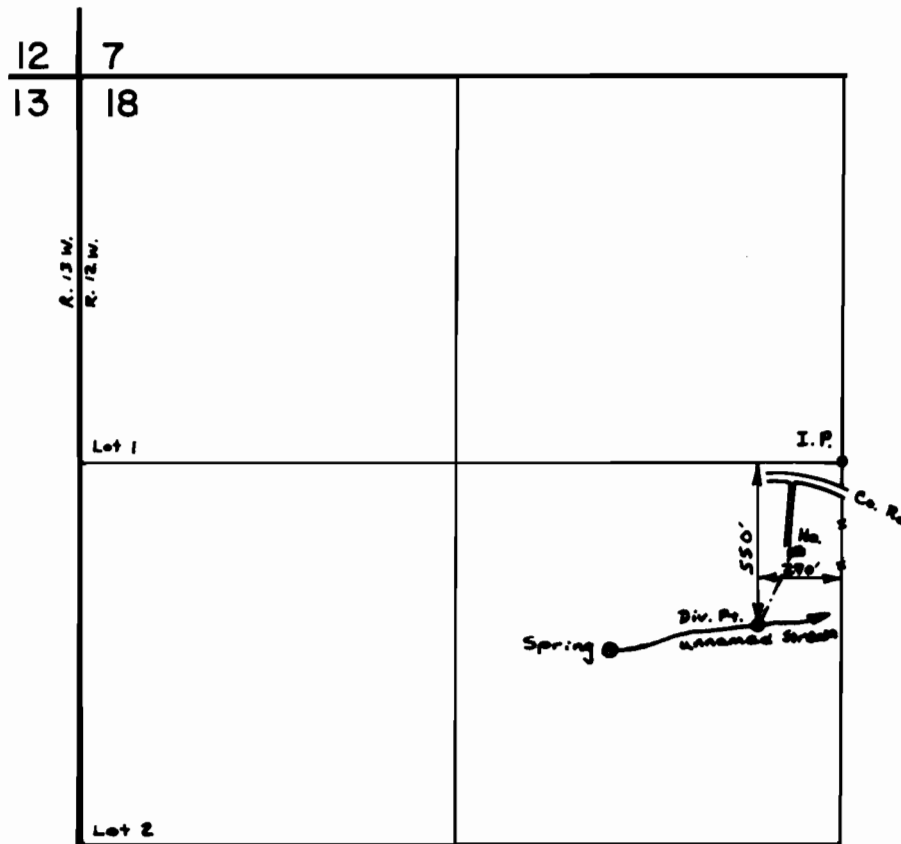

SCALE: 1" = 660'

**FINAL PROOF SURVEY**  
UNDER

Application No. 49154 Permit No. 36854  
IN NAME OF

VIRGIL & HAZEL HINES

Surveyed March 9 1978, by D. Sparks