


T.24S. R.12W. W.M.

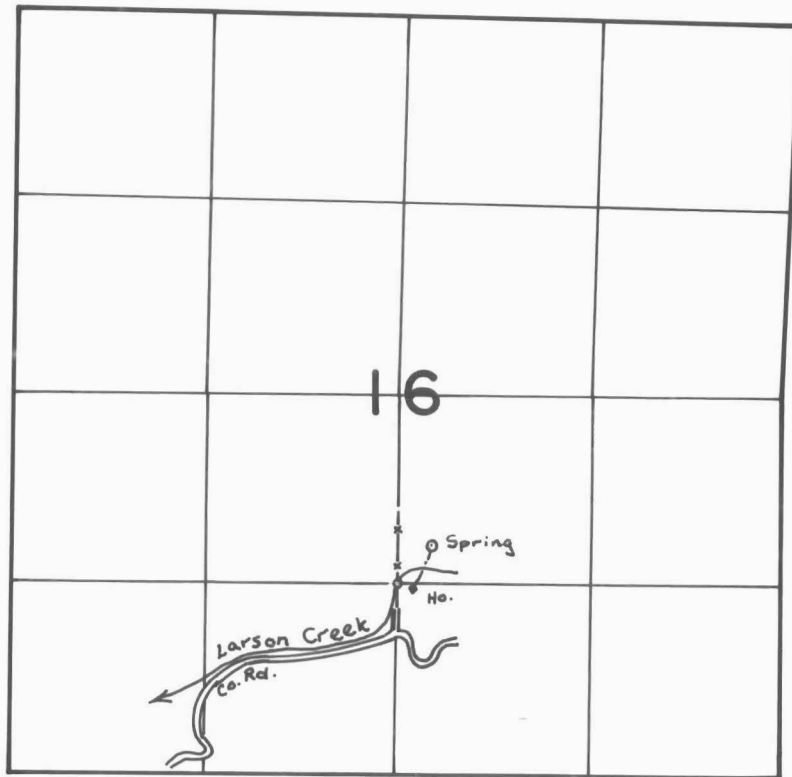

Spring Located: 250' N & 230' E from the SW cor. NW $\frac{1}{4}$  SE $\frac{1}{4}$  Sec. 16

SCALE: 4" = 1 mi.

**FINAL PROOF SURVEY**  
UNDER

Application No. 49608 Permit No. 37172

IN NAME OF

CHARLES R. & SELMA J. BROOKS

Surveyed March 8 1978, by D. Sparks