


T.29S. R.IIW. W.M.

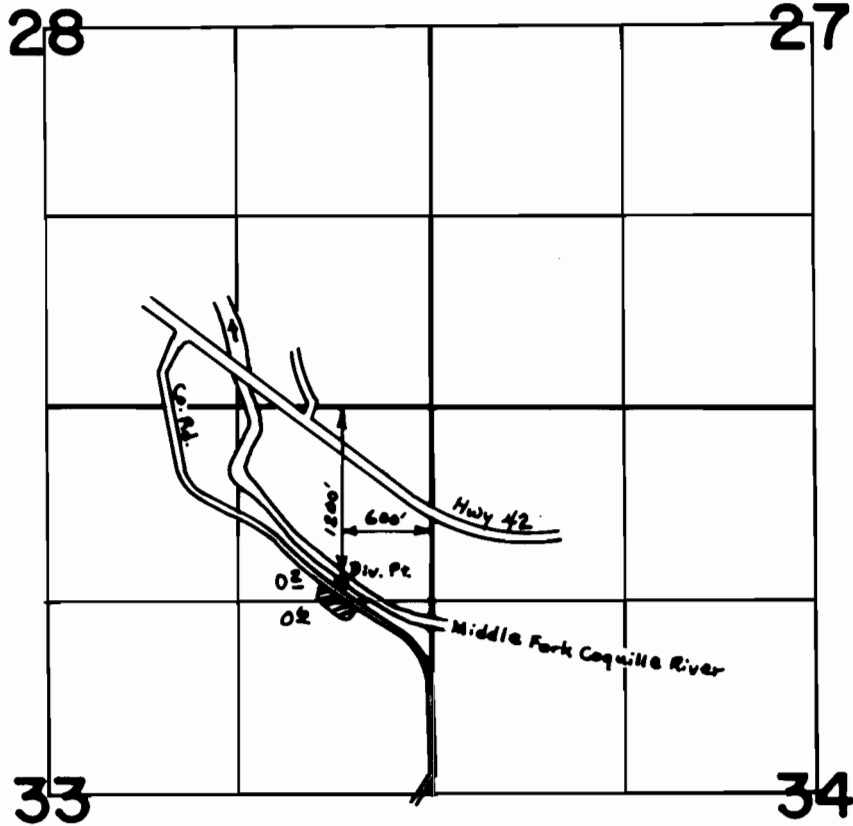

SCALE: 4" = 1 mile

**FINAL PROOF SURVEY
UNDER**

Application No. 51263 Permit No. 37434
IN NAME OF

GRETA & EDGAR PILLETTE

Surveyed Aug. 8 1978, by D. Sparks