


T.29S. R.12W. W.M.

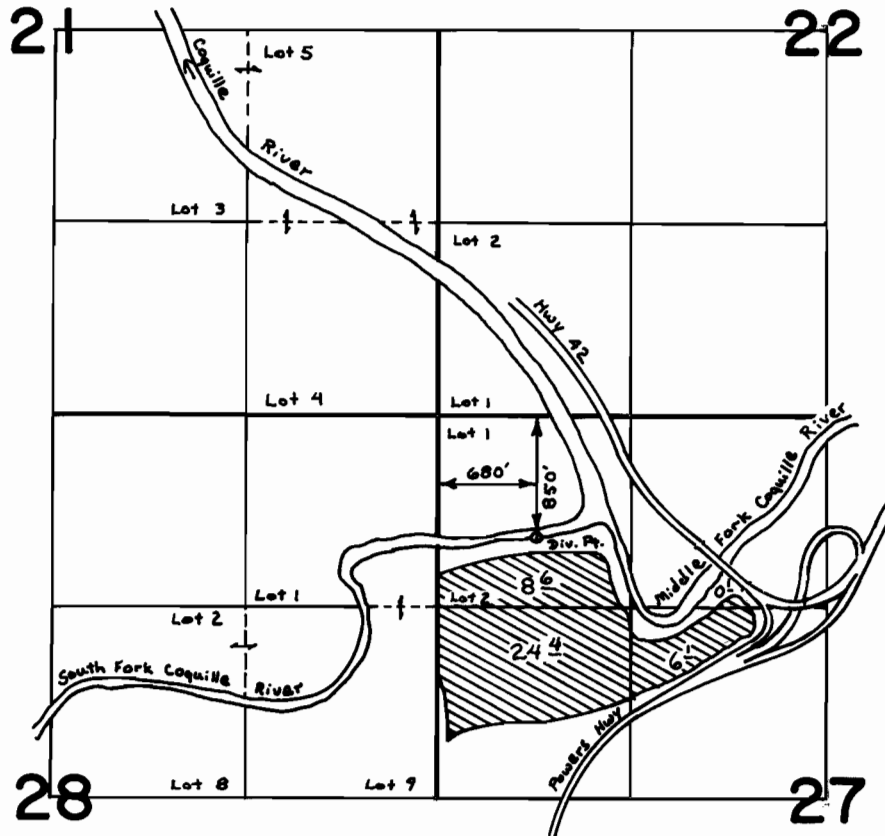

SCALE: 4" = 1 mi.

FINAL PROOF SURVEY
UNDER

Application No. 50412 Permit No. 38045
IN NAME OF

DALE LEE HOFFMAN

Surveyed May 18 1978, by D. Sparks