


T.29S. R.11W. W.M.

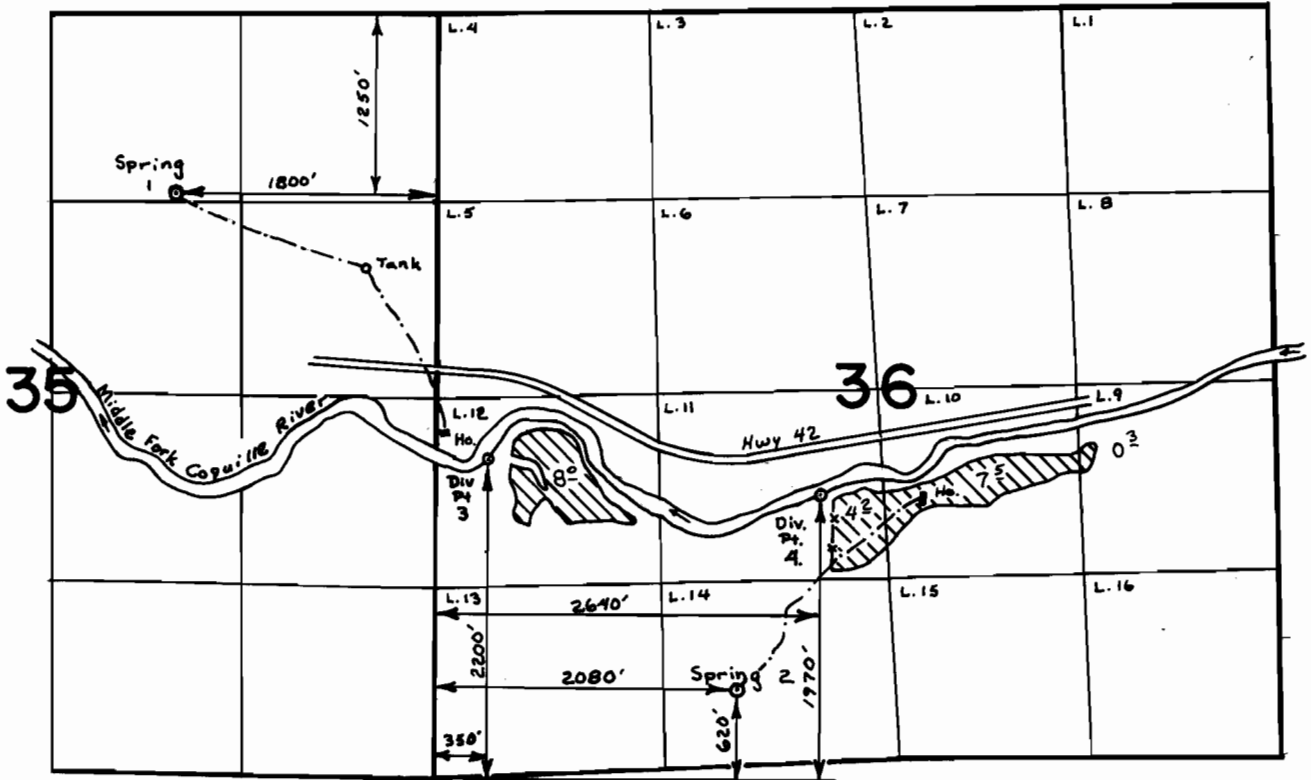

SCALE: 4" = 1 mi.

**FINAL PROOF SURVEY**  
UNDER

Application No. 50492 Permit No. 38129  
IN NAME OF  
EVERETT D. CULVER

Surveyed May 17, 1978, by D. Sparks