


T.29S. R.IIW. W.M.

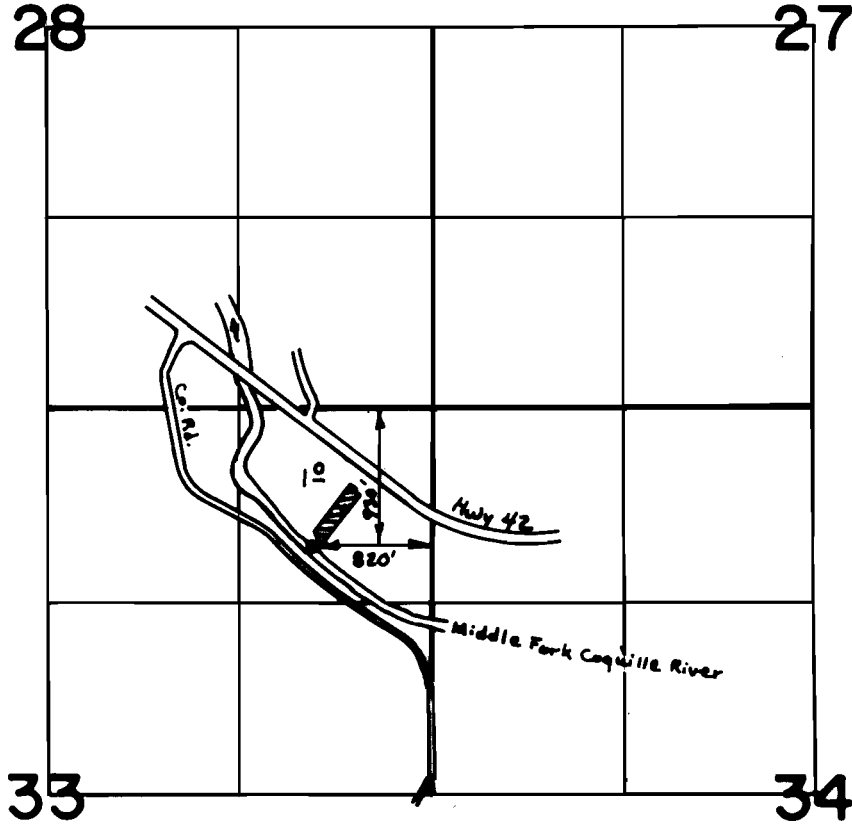

SCALE: 4" = 1 mile

FINAL PROOF SURVEY
UNDER

Application No. 51202 Permit No. 38690
IN NAME OF

HOWARD T. & HILDA A. MULTHAUF

Surveyed Aug. 7 1978, by D. Sparks