


T.27S. R.12W. W.M.

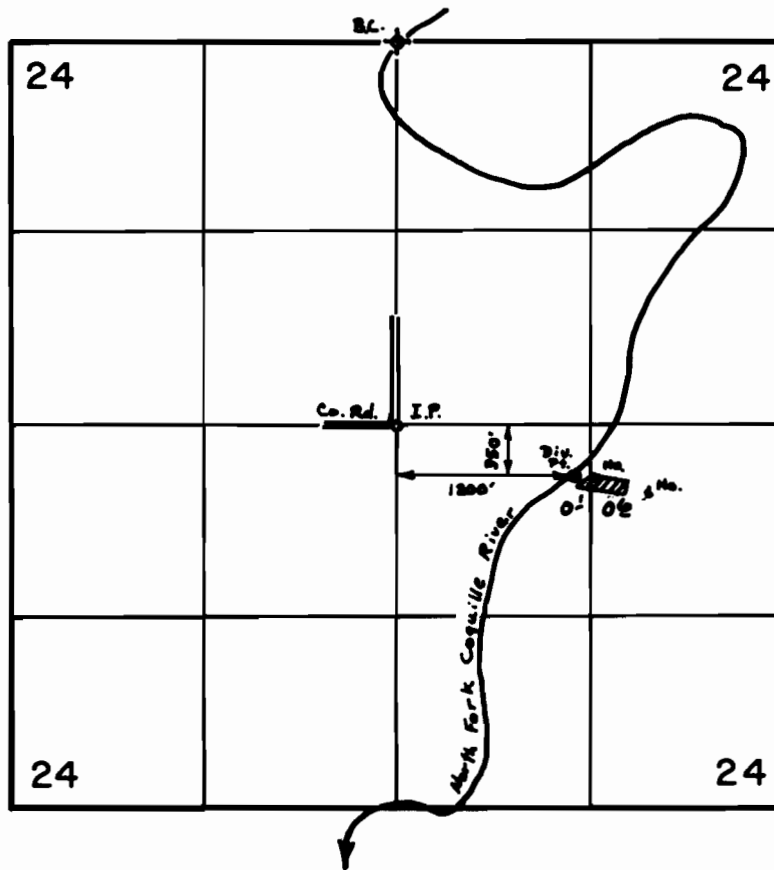

SCALE: 4" = 1mi.

**FINAL PROOF SURVEY**  
UNDER

Application No. 51935 Permit No. 39163  
IN NAME OF

HERBERT C. GRUNZ

Surveyed May 15, 1978, by D. Sparks