


T.29 S. R.12 W. W.M.

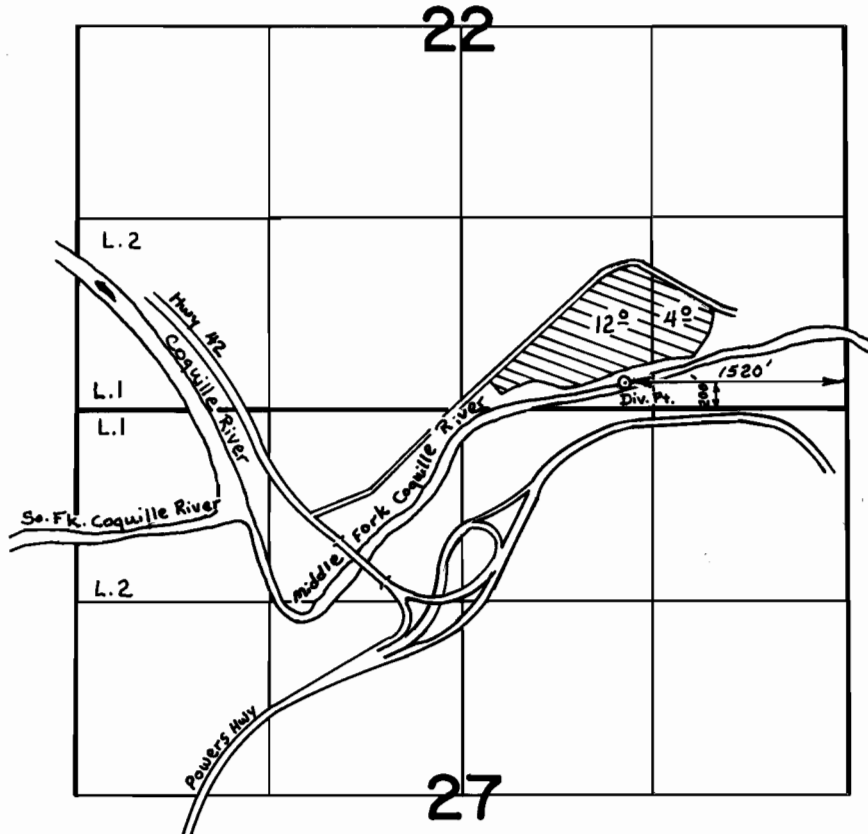

SCALE: 4" = 1 mile

FINAL PROOF SURVEY
UNDER

Application No. 51333 Permit No. 39386
IN NAME OF

THOMAS D. GUERIN

Surveyed Aug. 10, 1978, by D.W. SPARKS