


# T. 27S., R. 13W., W.M.

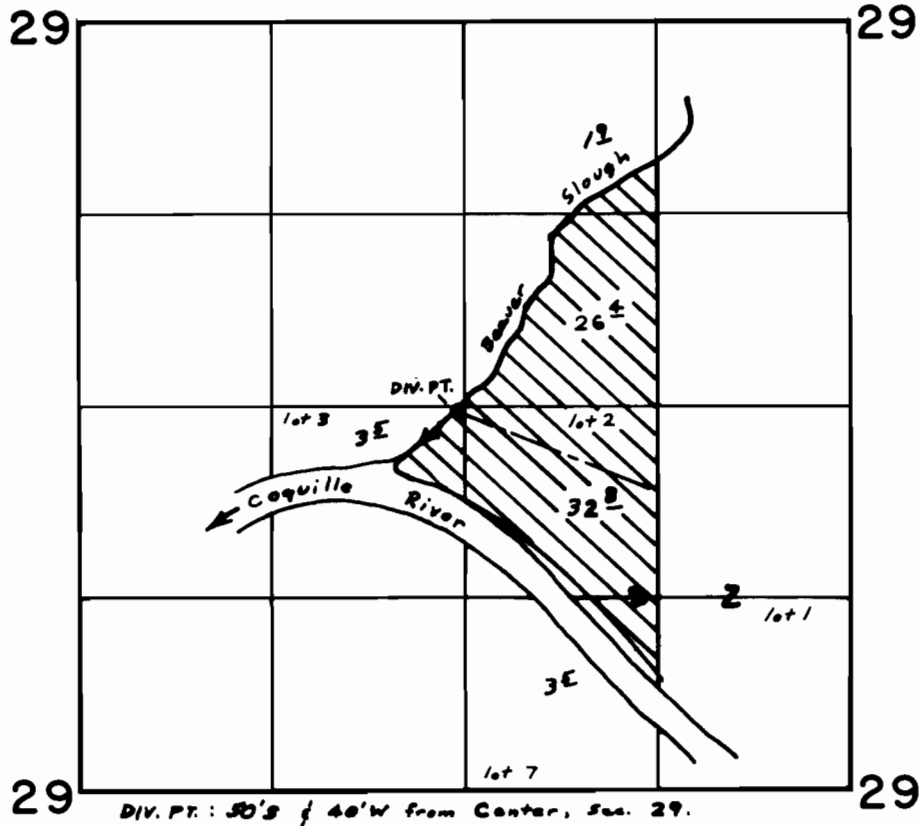

SCALE 4" = 1 mile

## FINAL PROOF SURVEY UNDER

Application No. 53565... Permit No. 40.Q81...  
IN NAME OF

.....THOMAS.....ROY.....KAY.....

Surveyed April 18, 1978, by B.R. SUND.....