


T. 25S. R. 12 & 13 W. W.M.

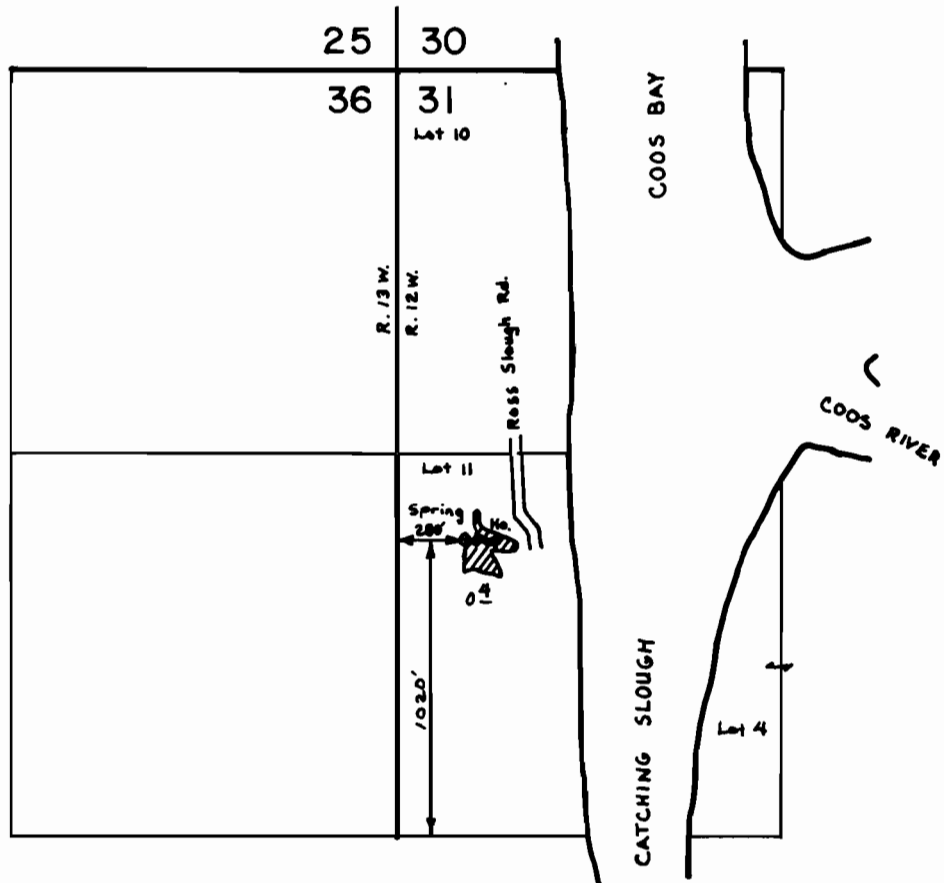

SCALE: 1" = 660'

**FINAL PROOF SURVEY
UNDER**

Application No. 53999 Permit No. 40265
IN NAME OF

TERRY WEAVER

Surveyed May 16, 1978, by D. Sparks