


T.28S., R.13W., W.M.

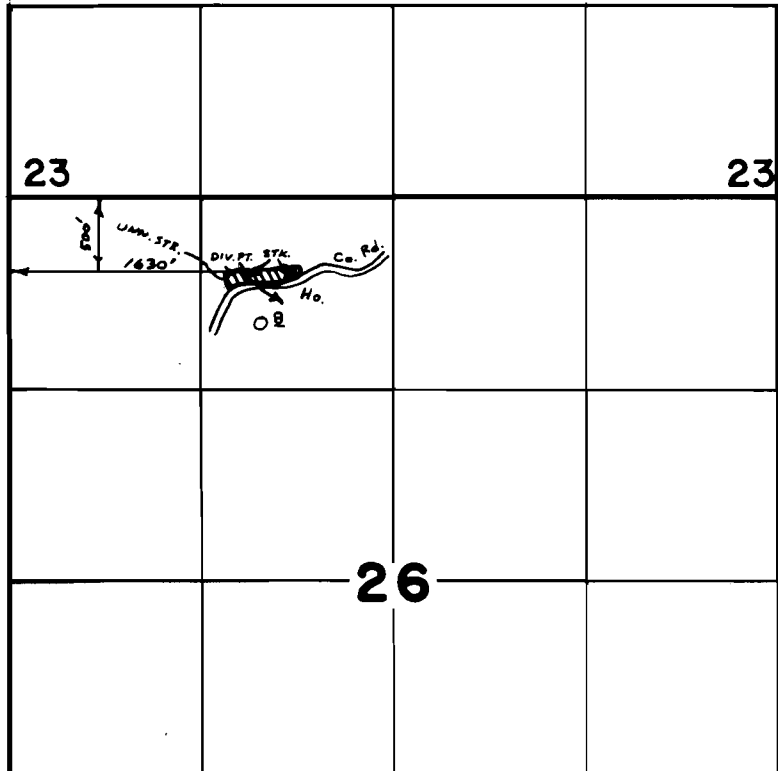

SCALE 4" = 1 mile

**FINAL PROOF SURVEY
UNDER**

Application No. 54413.. Permit No. 40803
IN NAME OF

.....ALBERT.....FRANCIS.....BARKLOW.

Surveyed Aug..9.. 1978, by Del..Sparks....