


T.25S. R.12W. W.M.

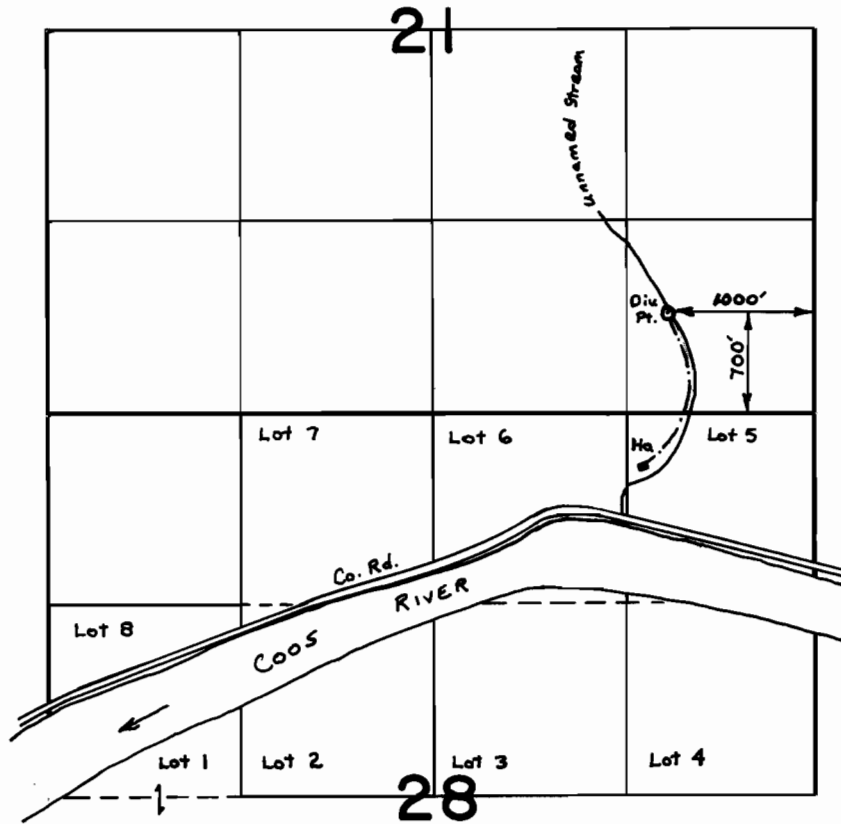

SCALE: 4" = 1mi.

**FINAL PROOF SURVEY**  
UNDER

Application No. 54969 Permit No. 41254  
IN NAME OF

JACK V. & ELLAPHARE J. KAUFFMAN

Surveyed March 8 1978, by D. Sparks