


T. 25 S. R. 12 W. W.M.

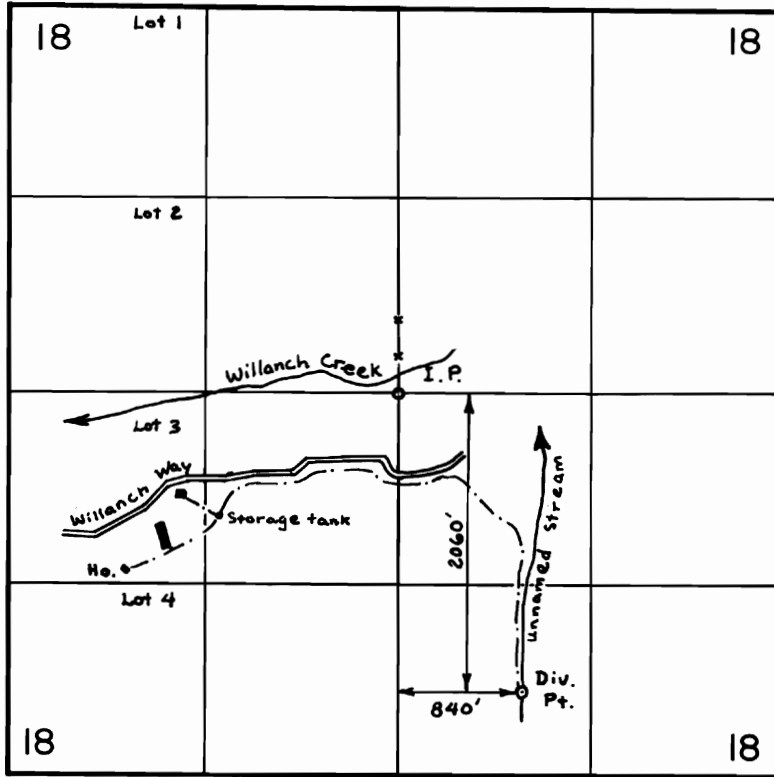

SCALE: 4" = 1mi.

**FINAL PROOF SURVEY**  
UNDER

Application No. 55274 Permit No. 41631  
IN NAME OF

FRANK B. ROOD

Surveyed May 16 1978, by D. Sparks