


T.28S. R.11W. W.M.

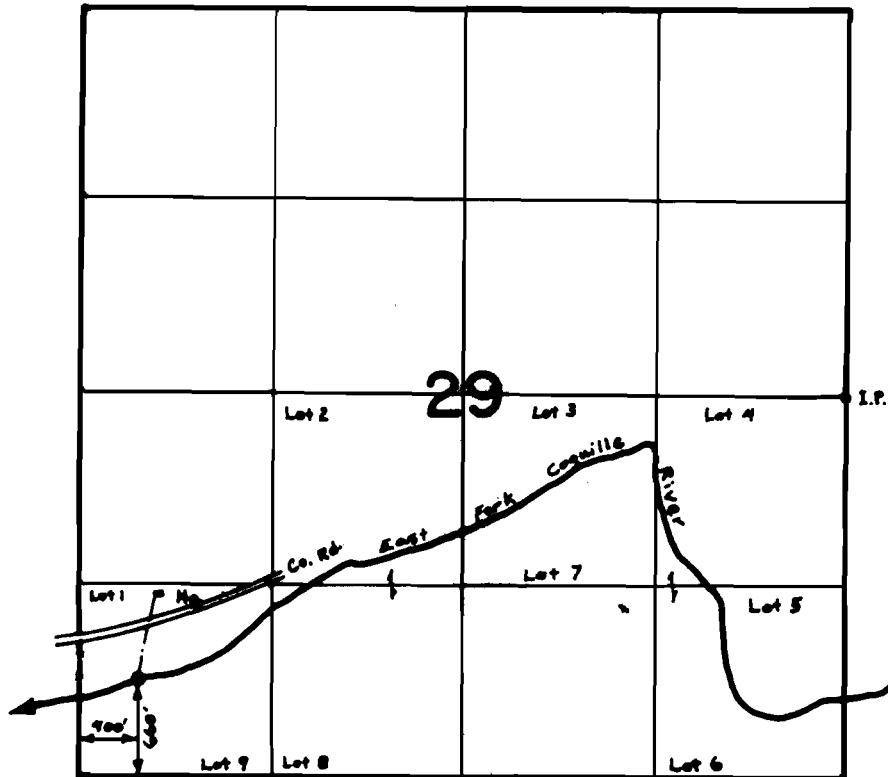

SCALE: 4" = 1 mi.

FINAL PROOF SURVEY
UNDER

Application No. 56071 Permit No. 41952
IN NAME OF

JACK E. LAFLANNE

Surveyed May 17, 1978, by D. Sparks