


T.25S. R.13W. W.M.

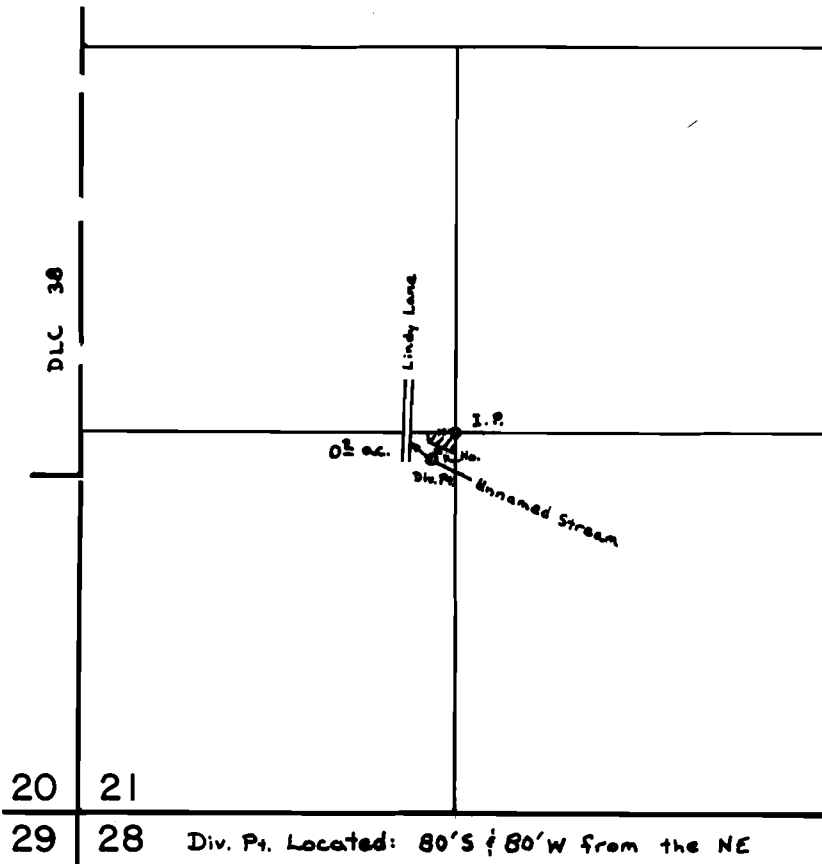

Div. Pt. Located: 80'S & 80'W from the NE corner of the SW/4SW/4 Sec. 21

SCALE: 1" = 660'

**FINAL PROOF SURVEY**  
UNDER

Application No. 56123 Permit No. 42083

IN NAME OF

ROBERT H. & DORIS E. GIBSON

Surveyed April 18 1978, by D. Sparks