


# T. 4 S., R. 1 W., W. M.

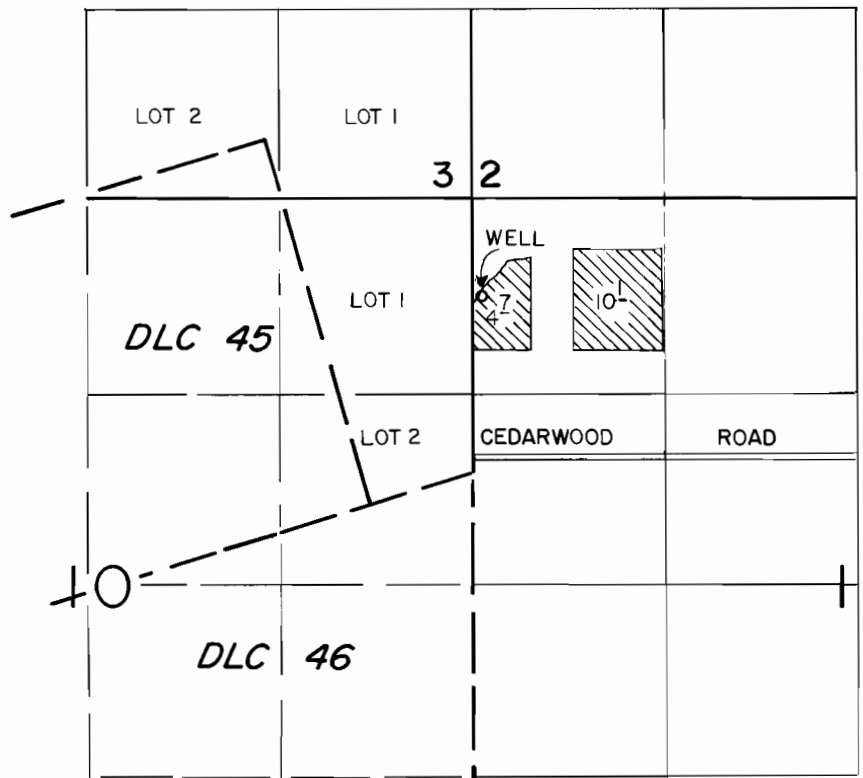

WELL LOC: 670' S. & 50' E. FROM THE N.W. COR. OF SEC. 11

SCALE: 1" = 1320'

## FINAL PROOF SURVEY UNDER

Application No. G-10975... Permit No. G-10177.....  
IN NAME OF

LEONARD W. PETERS

Surveyed AUG. 27, 1985, by B.W. BISHOP.....