

T. 39S. R. 3W. W.M.

RECEIVED


DEC 7 1981

WATER RESOURCES DEPT  
SALE OREGON

Water Rights  
Map.

Application No. 63100

Permit No. 46655

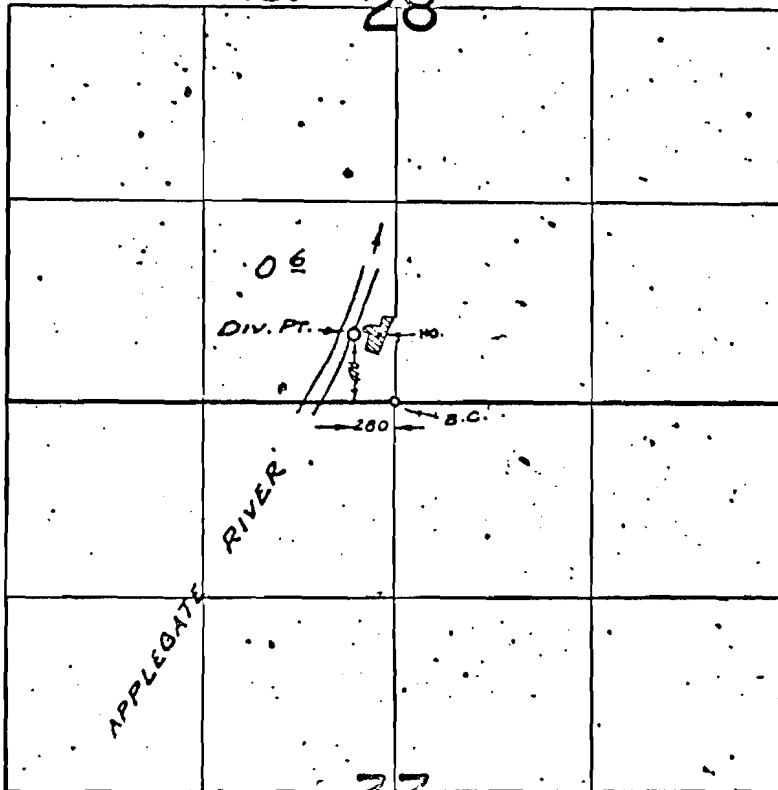

Map to accompany application for Theron E. Mechem and/or Helene A. Mechem for 2 acre feet of water from Applegate Lake Reservoir to supplementally irrigate 0.6 acre.

FINAL PROOF SURVEY  
UNDER

Application No. ~~38655~~ Permit No. ~~28746~~  
IN NAME OF

FRED & DOROTHY NOACK

Surveyed Aug. 10, 1971, by G. BACA

CERT. NO. 38958