


T. 38S. R. 4W. W.M.

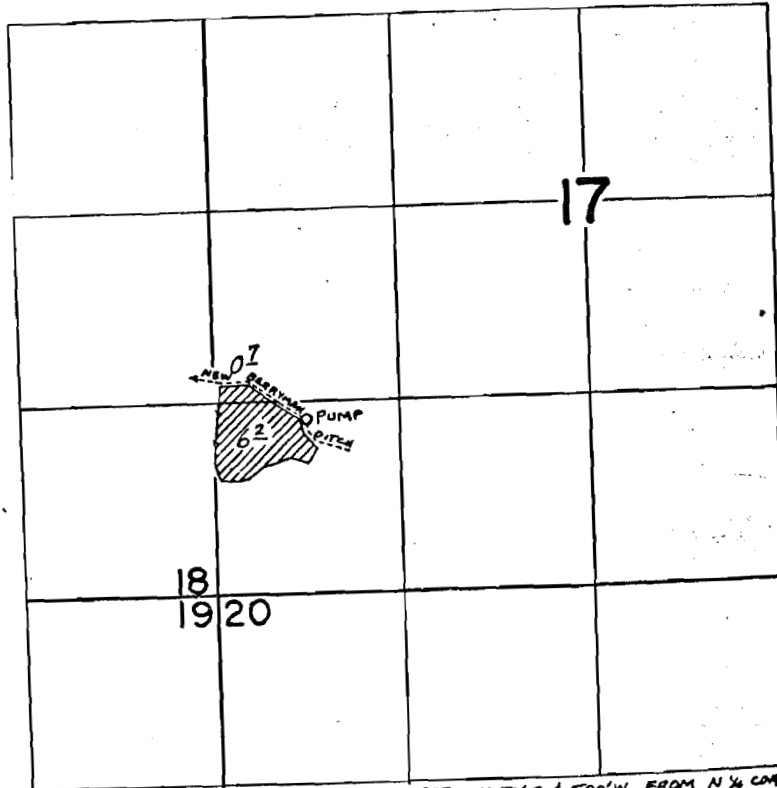

DIV. PT. FROM APPLGATE RIVER LOCATED: 1050'S. & 500'W. FROM N 1/4 COR. SEC. 25.

Application No. 63204  
Permit No. 46694