


Application No. 62144
Permit No. 46361

T. 40 S. R. 3 W. W. M.

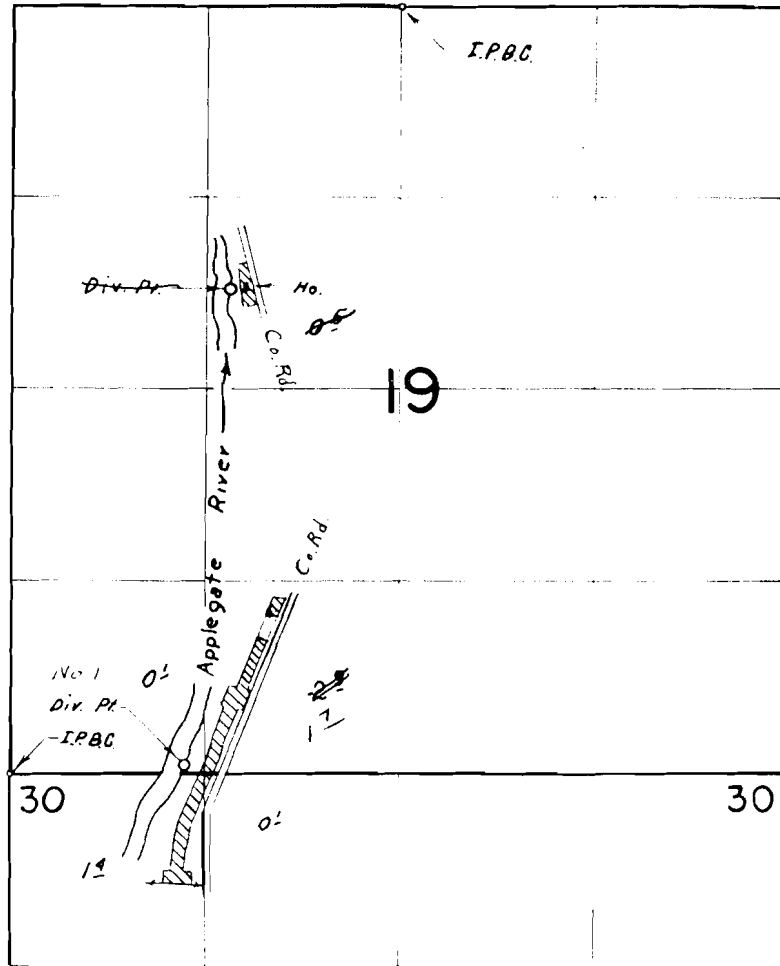

RECEIVED
AUG 6 1981
WATER RESOURCES DEPT.
SALEM, OREGON

Richard Leever
11/23/81

DIV. PT. LOC.: DIV. NO. 1 - 50' N & 1190' E FROM SW COR. SEC. 19
DIV. NO. 2 - 1940' S & 1160' W FROM N 1/4 COR. SEC. 19

Map to accompany application of Martin and/or Linda Heitkamp and Richard and/or Rose Leever to appropriate 4 acre feet of water from Applegate Lake Reservoir to supplementally irrigate 2.30 acres as shown shaded in yellow above.

FINAL PROOF SURVEY
UNDER

Application No. 37843 Permit No. 28212
IN NAME OF

MRS. GERTRUDE HEITKAMP

Surveyed SEP. 17, 1971, by L. E. Gould