


T.40S.R.3W.W.M.

RECEIVED
SEP 04 1981
WATER RESOURCES DEPT
SALEM, OREGON

Application No. 62948
Permit No. 46147

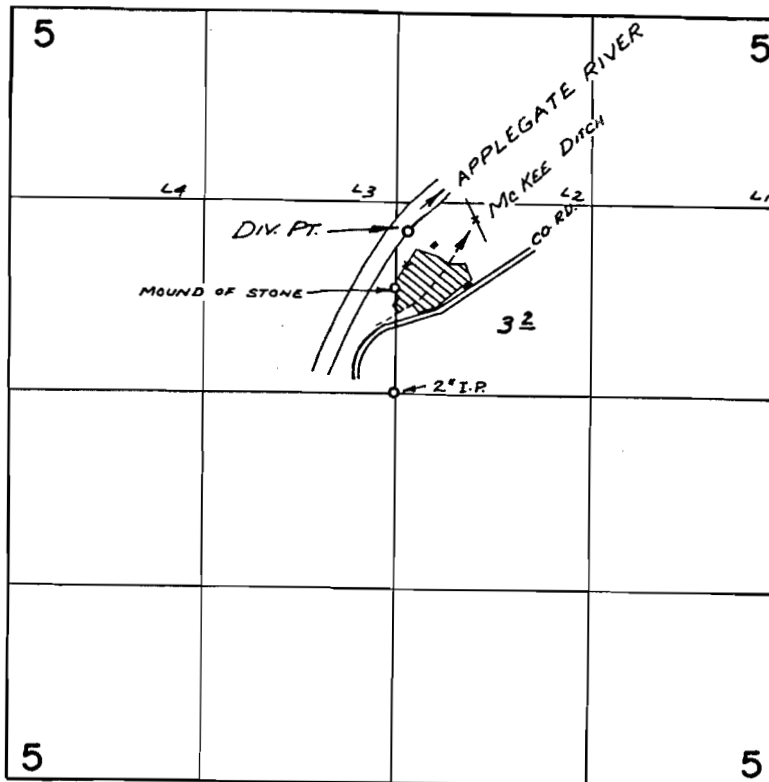

DIV. PT. LOC: 1110' N. & 80' E. FROM CEN. SEC. 5
MAP TO ACCOMPANY APPLICATION OF
JAMES E. AND/OR MARY E. ECK FOR SUPPL.
IRR. FROM APPELEGATE LAKE RESERVOIR

FINAL PROOF SURVEY UNDER

Application No. 47604..... Permit No. 35633.....
IN NAME OF

.....JAMES E. & MARY E. ECK.....

Surveyed SEPT. 23, 1974, by R. MUCKEN.

8-6-81