


RECEIVED

JUL 7 1981

WATER RESOURCES DEPT  
SALEM, OREGON


T.38 S., R.4 W., W.M.

Application No. 61867  
Permit No. 46302

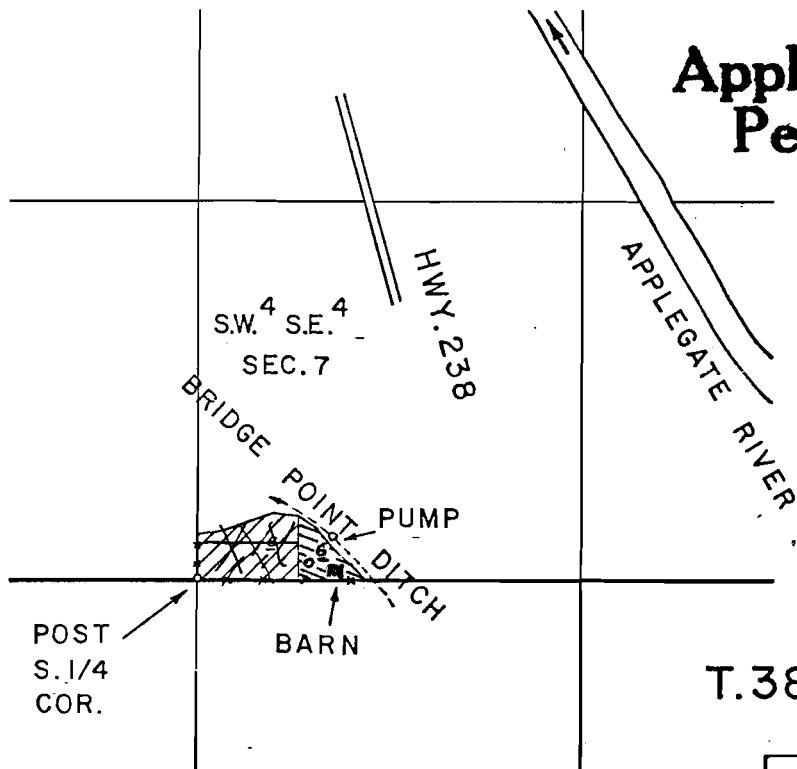

SCALE: 1" = 660 FT.

T.38 S., R.4 W., W.M.

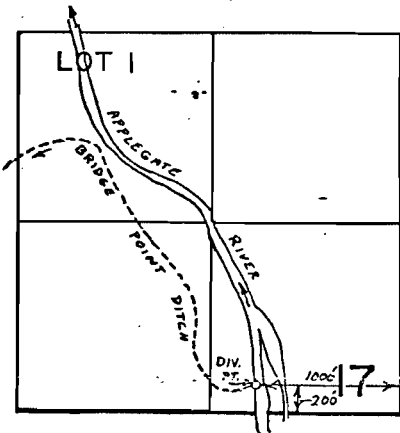

~~FINAL PROOF SURVEY~~  
~~UNDER~~

~~Application No. 28228~~ ~~Permit No. 43123~~  
IN NAME OF

MRS. FLOSSIE CARL and/or VERA CARL

~~Surveyed~~ OCT 12 1978 ~~by~~ B. SUND

D.H.M.  
P.T.S.-1978-14-D  
& BAX-4AA-166

B.S.J.