


Application No. 62026  
 Permit No. 45945

34933

T.37&38S. R.4&5W. W.M.

RECEIVED  
 JUN 5 1978  
 WM. DIST. 14  
 GRANTS PASS, ORE

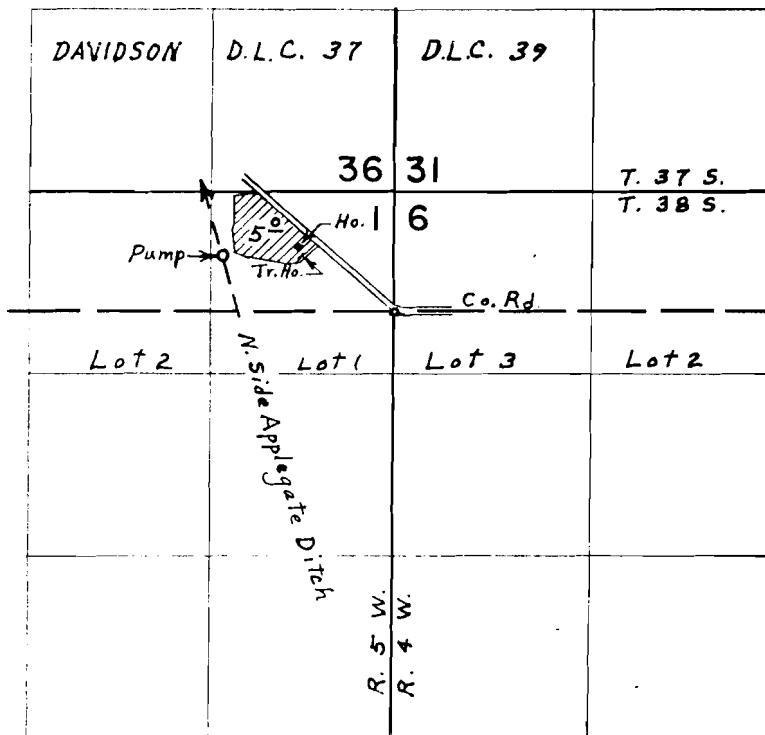

Diversion Point: 4000'S E 80'E from NW corner Section 6  
 T38S R4WWM

RECEIVED

JUL 31 1981

FINAL PROOF SURVEY  
 UNDER

WATER RESOURCES DEPT  
 SALEM, OREGON

Application No. 46783 Permit No. 34933

IN NAME OF

ARTHUR E. ENGNELL

Harold Embury

OCT - 2 1985

Surveyed May 21, 1975, by L. E. Gould.

WATER RESOURCES DEPT  
 SALEM, OREGON