


T.8S.,R.10W.,W.M.

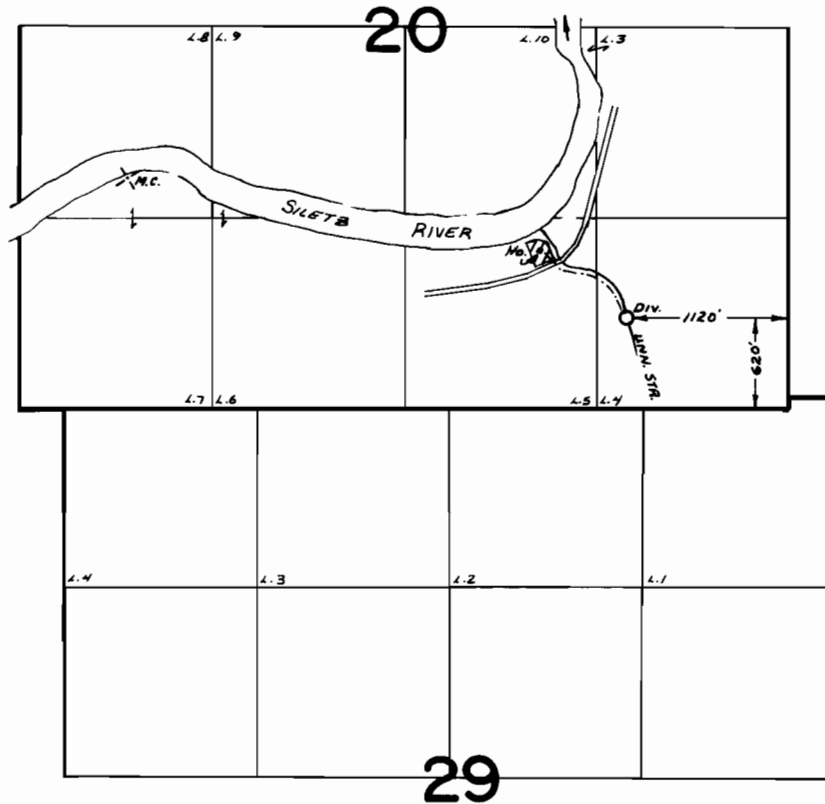

FINAL PROOF SURVEY UNDER

Application No. 59697 Permit No. 44859.....
IN NAME OF

WILLIAM...OR...BETTY...ANN...ROHDE

Surveyed Oct...22, 1981., by S...C...BROWN.....