


T.8S., R.19E., W.M.

P-41914
C-53715

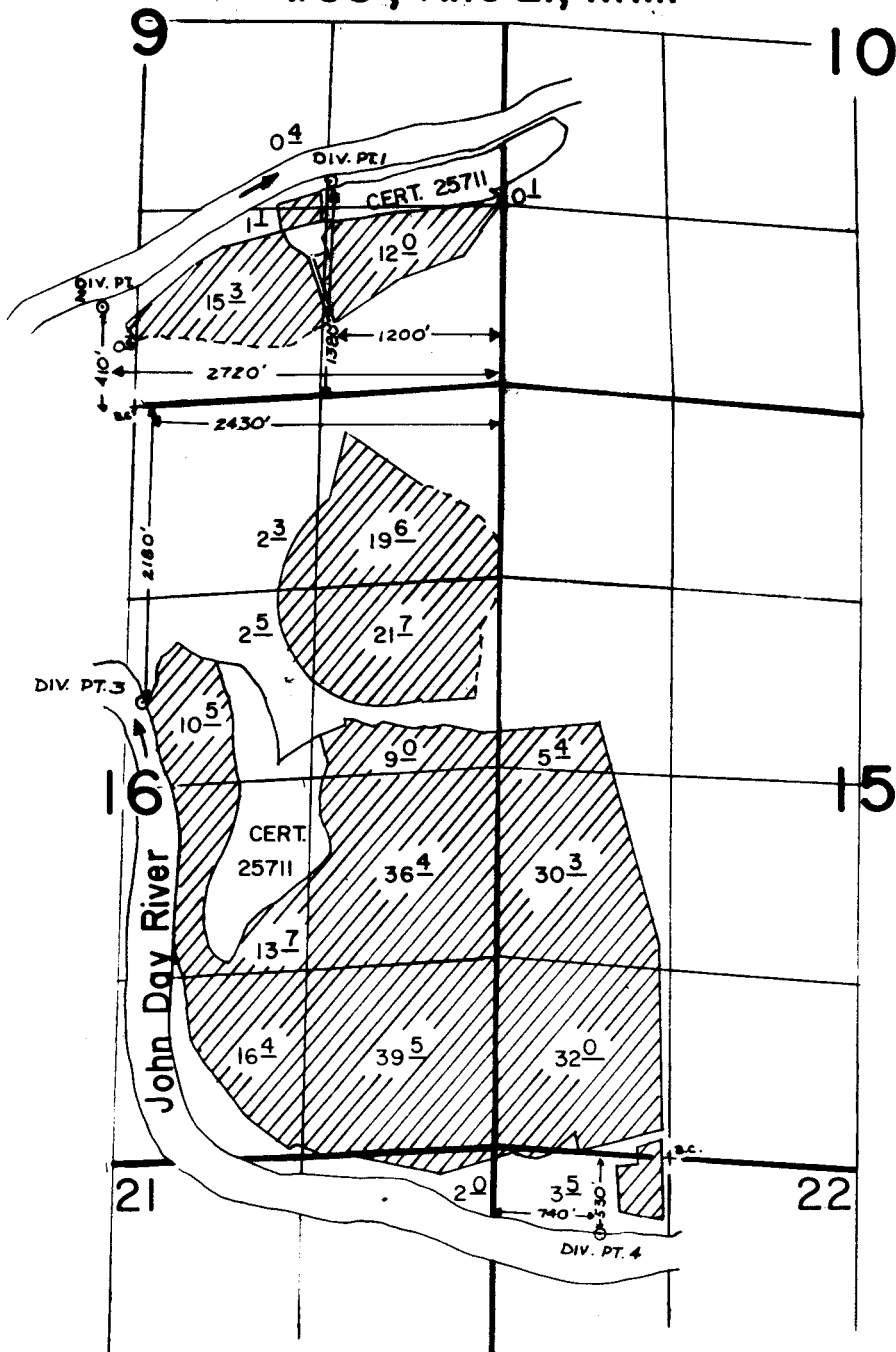

SCALE: 1"=1320'

FINAL PROOF SURVEY UNDER

Application No. 55879... Permit No. 41914.....
IN NAME OF

WILLIAM J. & BARBARA BOWERMAN

Surveyed OCT...8... 19.82., by L.H. NUNN.....