



Mapped, edited, and published by the Geological Survey
Control by USGS and NOS/NOAA
Topography by photogrammetric methods from aerial
photographs taken 1971. Field checked 1972
Projection and 10,000-foot grid ticks: Oregon coordinate
system, north zone (Lambert conformal conic)
1000-metre Universal Transverse Mercator grid ticks,
zone 11, shown in blue. 1927 North American datum

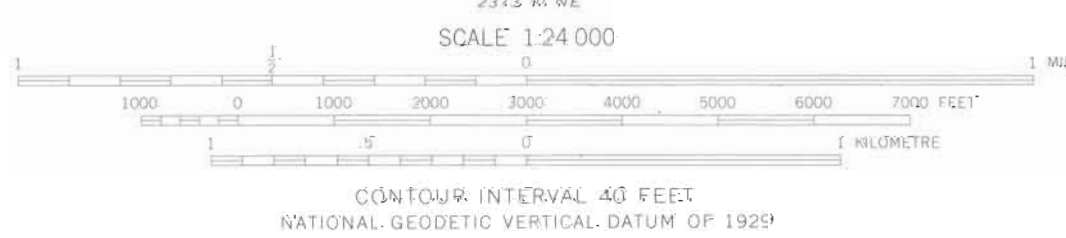

ROAD CLASSIFICATION

Primary highway, hard surface	Light-duty road, hard or improved surface
Secondary highway, hard surface	Unimproved road
Interstate Route	U.S. Route
	State Route

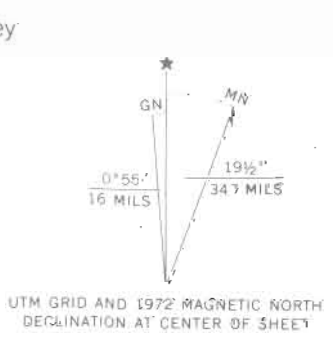

MT. IRELAND, OREG.
N445-W11815/7.5

1972

AMS 2475 IV SE - SERIES V892

FINAL PROOF SURVEY
UNDER

Application No. 37009 Permit No. 27703
IN NAME OF
KEN ALEXANDER

Surveyed July 30 1979 by V. Church

Ed Dept