


T. 6S. R. 39E. W.M.

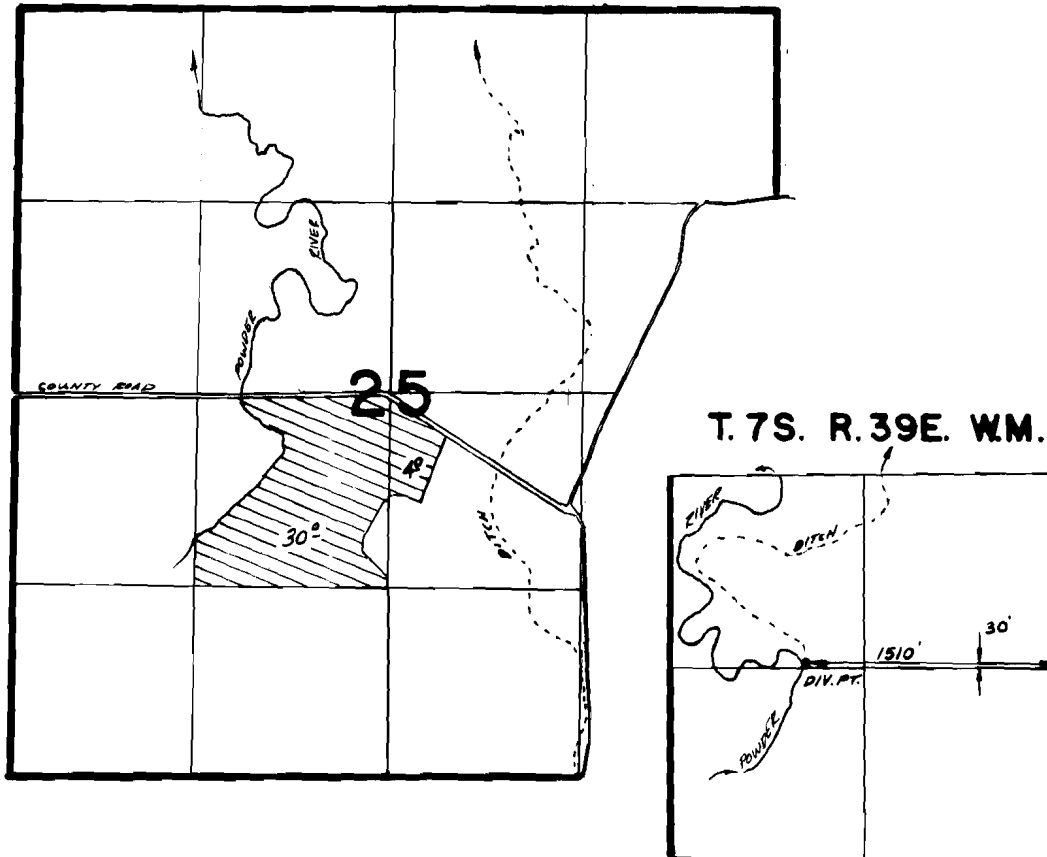

FINAL PROOF SURVEY
UNDER

Application No. **55948** Permit No. **42792**
IN NAME OF

MARVIN D. & MARY L. CROPP

Surveyed *7-28* 197*9*, by *L. Edward A. Jewett*