


T. 7S. R. 38E. W.M.

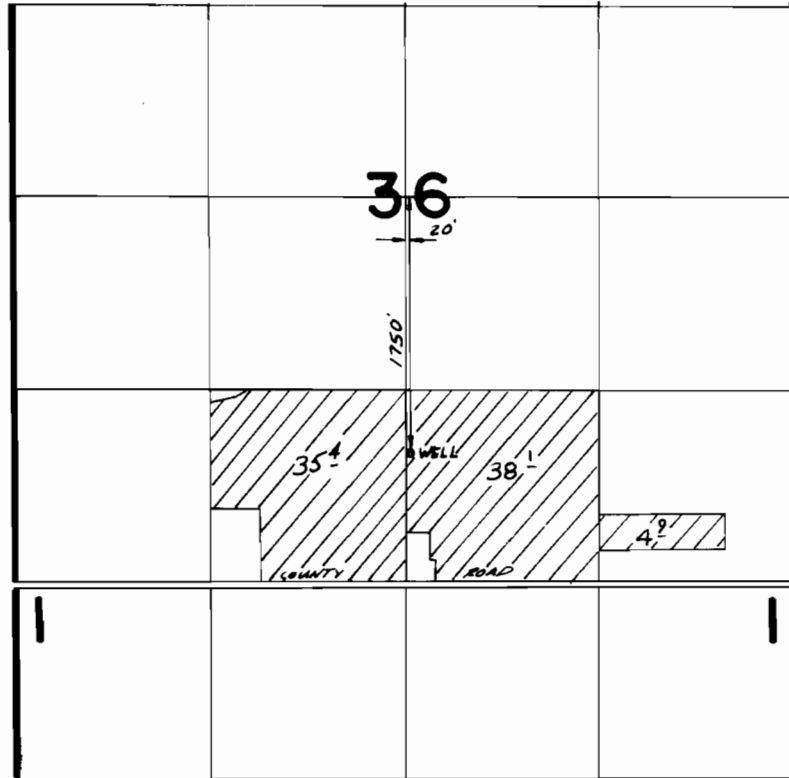

FINAL PROOF SURVEY
UNDER

Application No. *G-6264*. Permit No. *G-5251*....
IN NAME OF

DONALD WILLIAM CHRISTY

Surveyed *7-31*..... *1979*.. by *J. Church & P. Jewett*