

Application for Permit
Duncan D. MacKenzie
Rockville Route
Jordan Valley, Ore 97910

Application No. _____

Permit No. _____

Application No. **67534**
Permit No. **48746**

Land in Malheur County, Oregon
In Twp. 27 S., R. 14 E., W.M.

Section 5: NE $\frac{1}{4}$ SW $\frac{1}{4}$



Scale 1"=1000'


NW cor
Sect

NE cor
Sect

Legend

• - spring


○ - tank

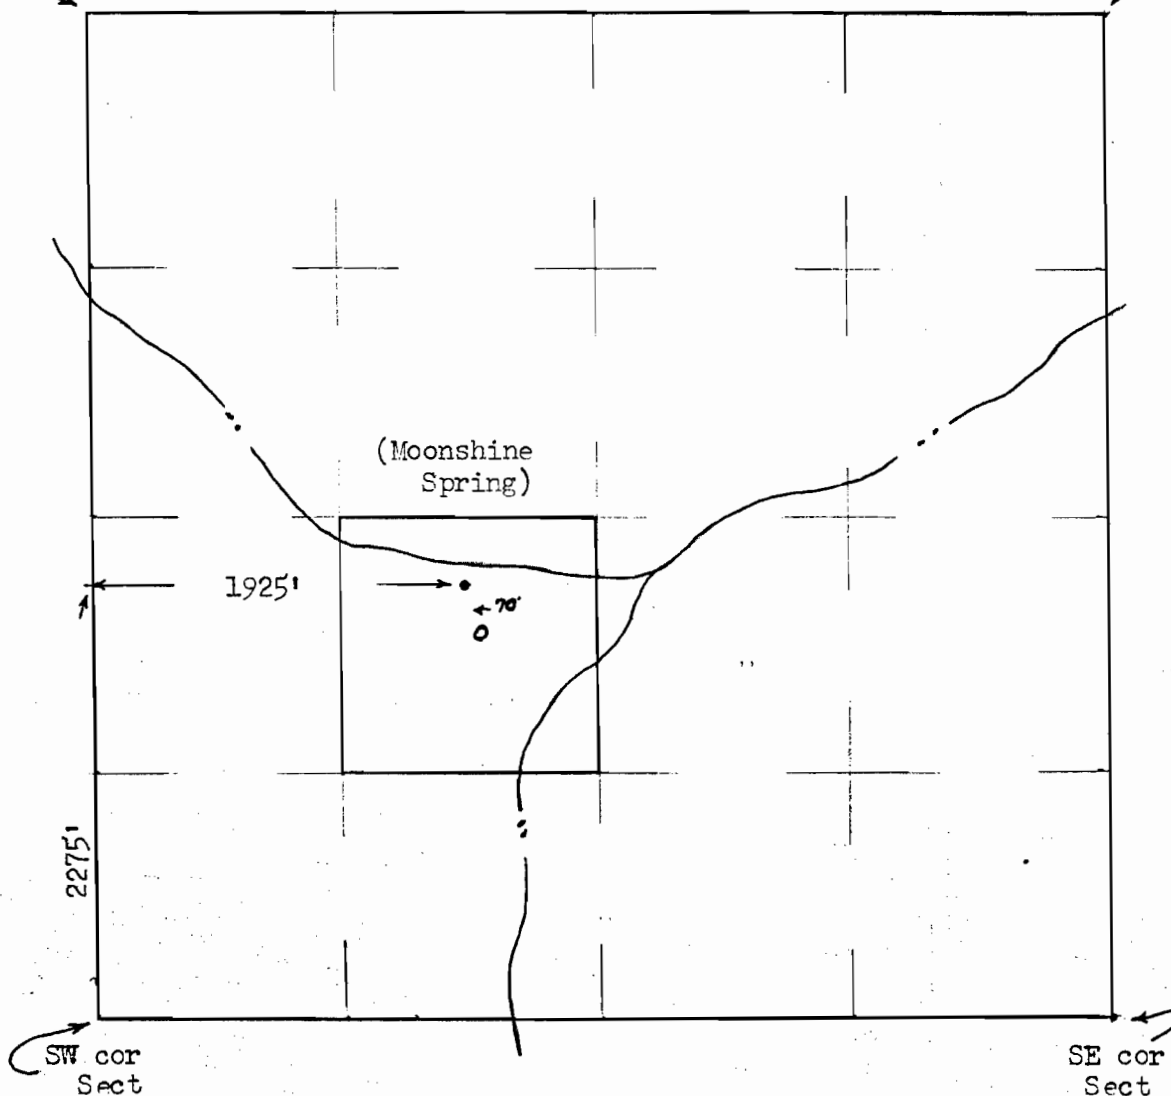

INFO-PERSONAL OBSERVATION

SPRING- ON HILLSIDE ABOVE BOTTOM IN DRAW
APPARENTLY AREA EXCAVATED AND WORKS
ALL PLACED ~~BE~~ THEN COVERED.

WORKS- GRAVITY FLOW TO STOCK TANK (3 1/2' x 14 1/2')
1 1/4" GALVANIZED PIPE FLOWING FULL INTO STOCK
TANK.

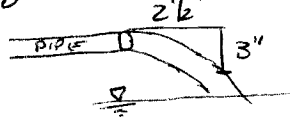

STOCK TANK IS APPROX 30 FT FROM SPRING
(PROJECT MARKER)

AT SPRING SITE THERE IS AN 1 1/2" BLACK
PLASTIC PIPE THAT APPEARS TO BE AN
OVERFLOW PIPE

USE- STOCK ~~BE~~ DIRECT FROM TANK

TIE - SEE MCCAIN CREEK QUAD (copy attached)

Randy Jell
WRE
6/4/85

5/30/85
Confirmed findings
with Doreen
MacKenzie CMT

MOONSHINE
SPR
1260 6242-4926

1975



