

Application for Permit
Duncan D. MacKenzie
Rockville Route
Jordan Valley, Ore 97910

Application No. _____

Permit No. _____


Application No. 67536

Permit No. 48748

Land in Malheur County, Oregon
In Twp. 23 S., R. 45 E., W.M.

Section 11 : NW $\frac{1}{4}$ NW $\frac{1}{4}$

↑
N
Scale 1"=1000'

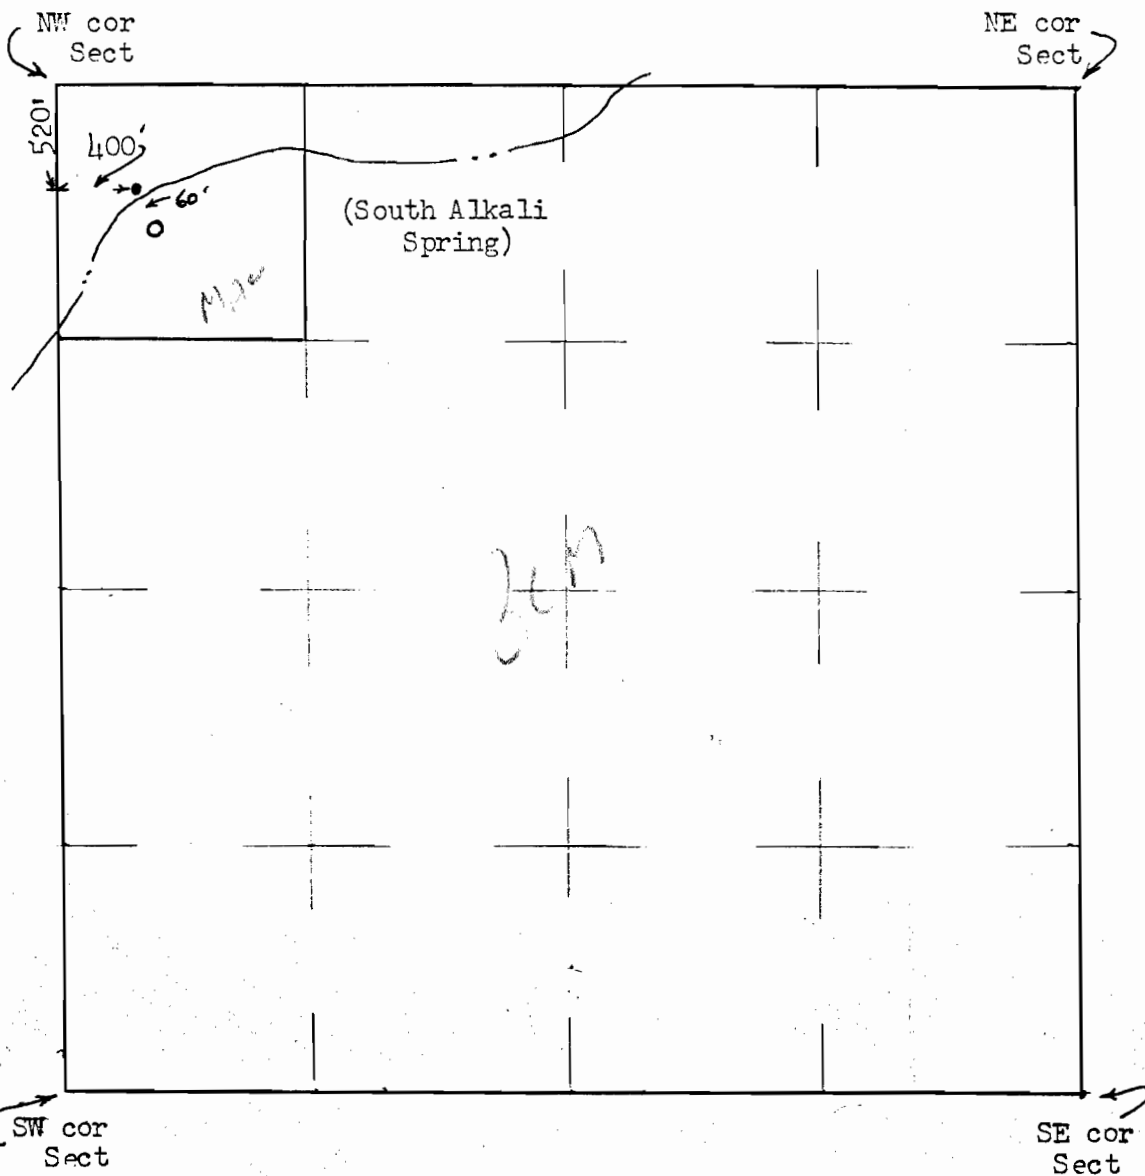


Legend

• - spring

○ - tank

A COPY OF A PORTION OF OWYHEE RIDGE QUAD

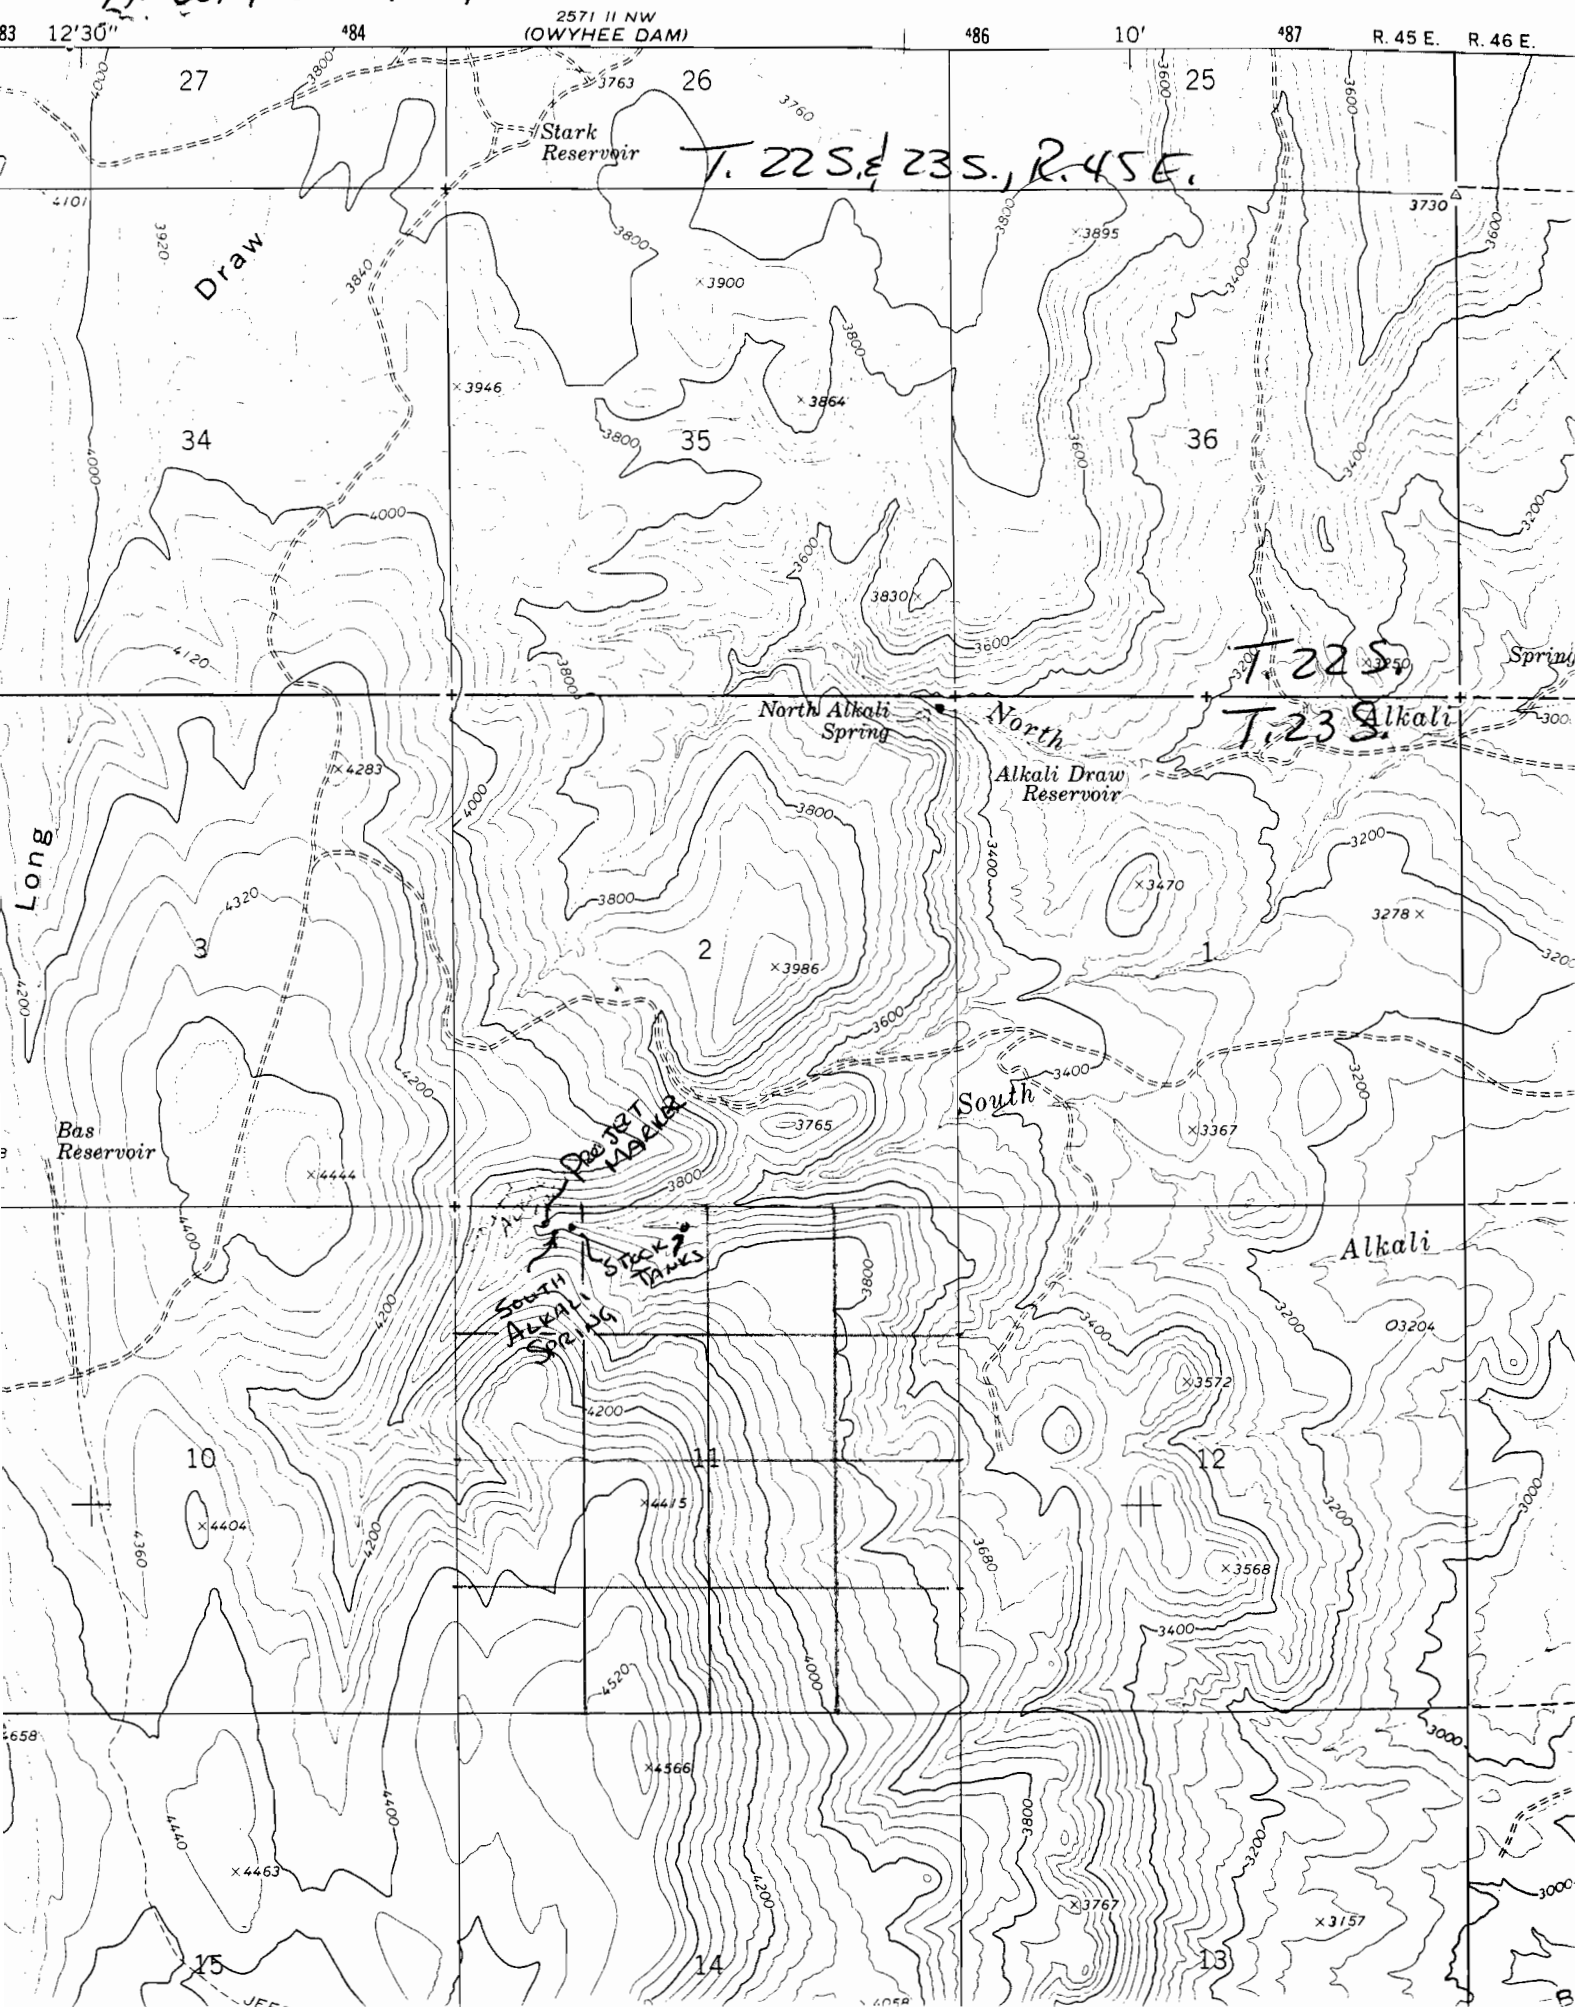

T 23 S. R 45 E Sec. 11

T23S R 45E W.M.
MALHEUR COUNTY

T. 23 S., R. 45 E. W.M.
Application No. 67536
Permit No. 48748

SEE MAP 22 45

1" = 2000'

