




T.8S. R.2W., W.M.

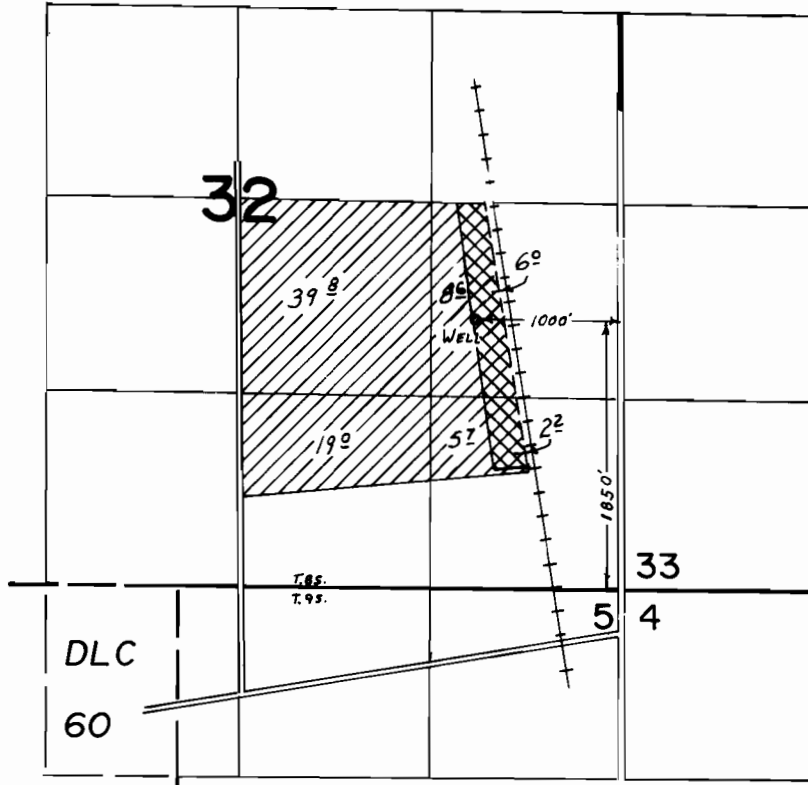

-  - Primary
-  - Supplemental

FINAL PROOF SURVEY UNDER

Application No. G-7414.. Permit No. G-6918.....
IN NAME OF

.....DONALD J. or JOAN B. ETZEL.....

Surveyed MAY...30. 1979., by L.H.NUNN.....