

C-39-24

T. 5N., R. 27 & 28E., W.M.

# FINAL PROOF SURVEY UNDER


APPL. 50239 PER. 37108

IN NAME OF

C & B LIVESTOCK, INC.

SCALE: 1" = 1320'

SURVEYED 5-12 1978, by R. BARWIN  
10-12 81 V. CHURCH  
5-23 85

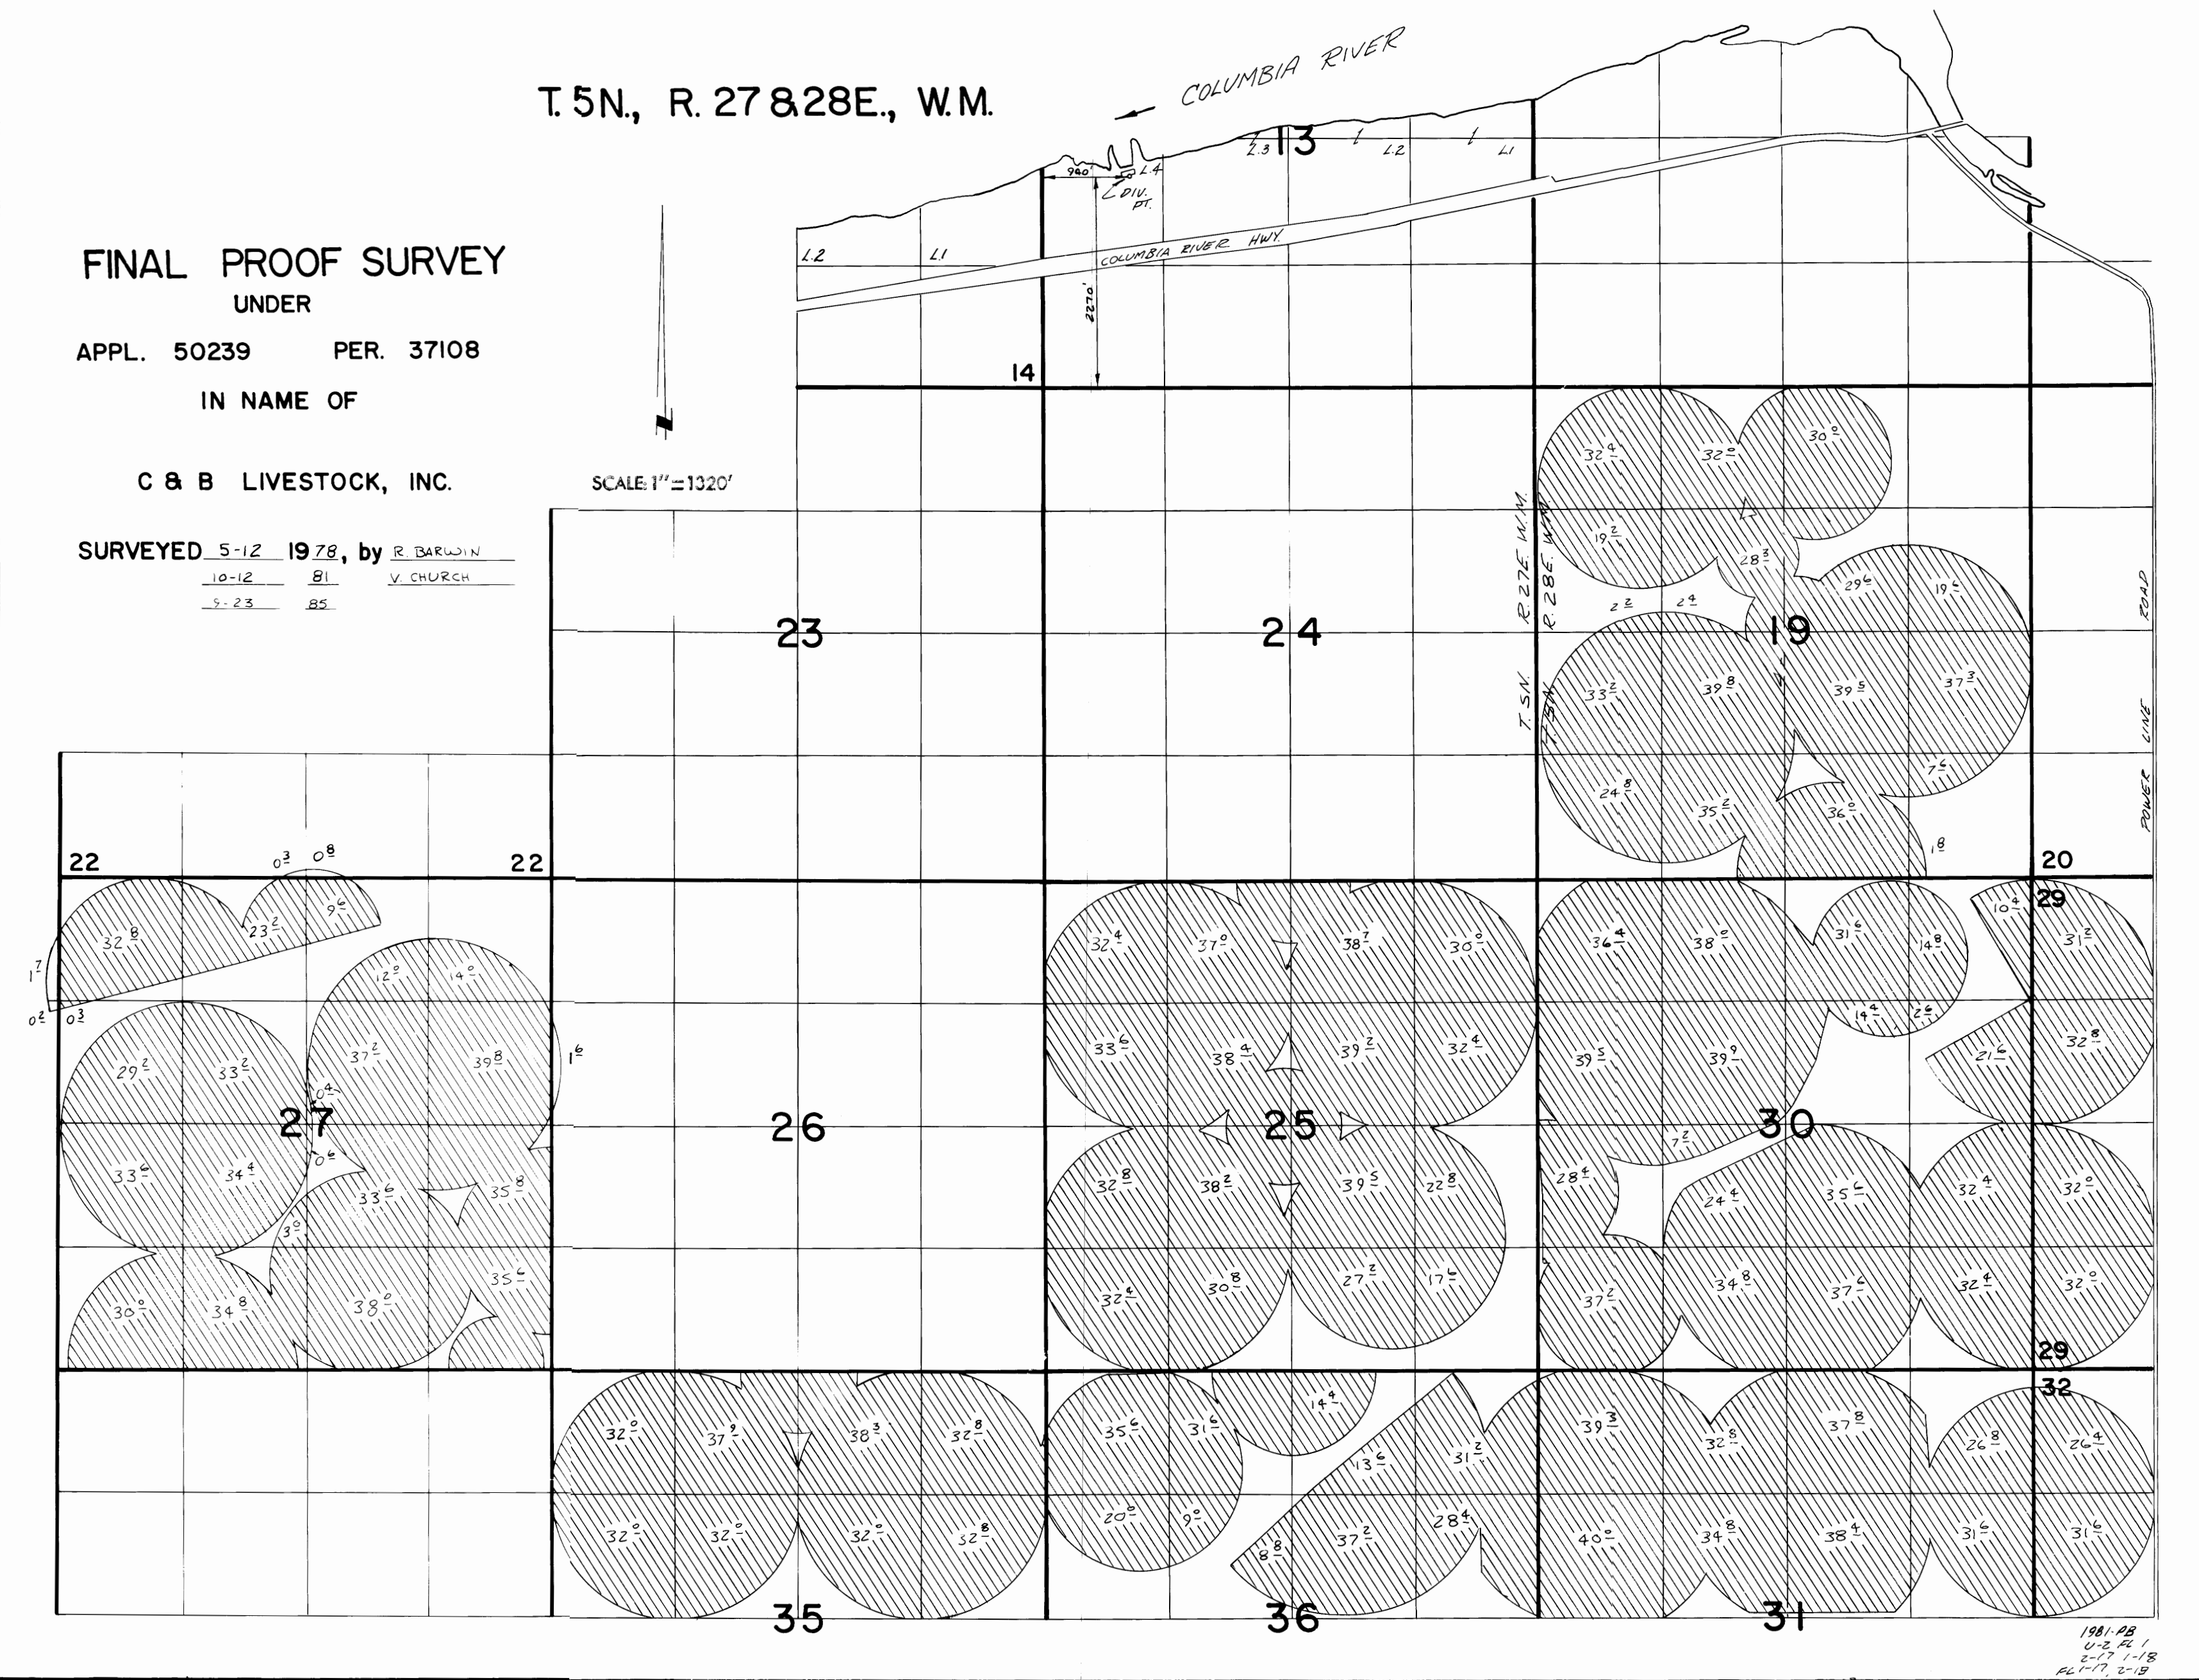

1981-PB  
 U-2, PL 1  
 2-17, 1-18  
 PL 1-17, 2-15  
 Rev. 9-24-85 KLC