


T. 3N., R. 28E., W. M.

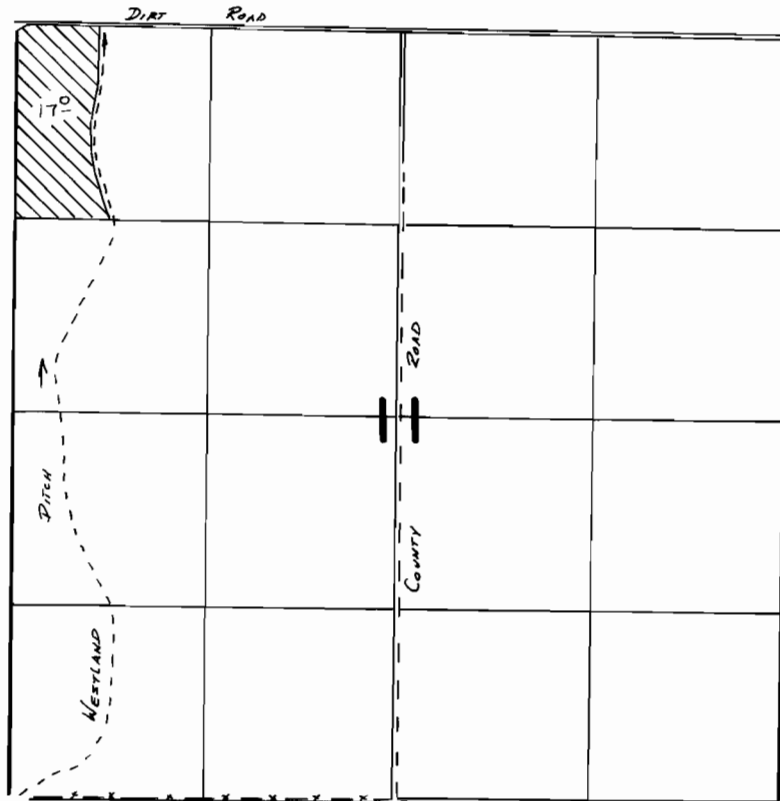

SCALE: 1" = 1320'

Div. Pr. Loc: N. 76° 45' 56" E. 2913.19' From W¹/₄ Cor. Sec. 21
T. 3N., R. 29E., W.M. (Westland Canal)

FINAL PROOF SURVEY
UNDER

Application No. **65131**.... Permit No. **47820**..
IN NAME OF

EMERT, BOB & COOMBES, BEN

Surveyed *Jan. 10*.... 19*85*., by *V. L. Church*.....