


G-6142  
53737

T. 4N., R. 29E., W.M.

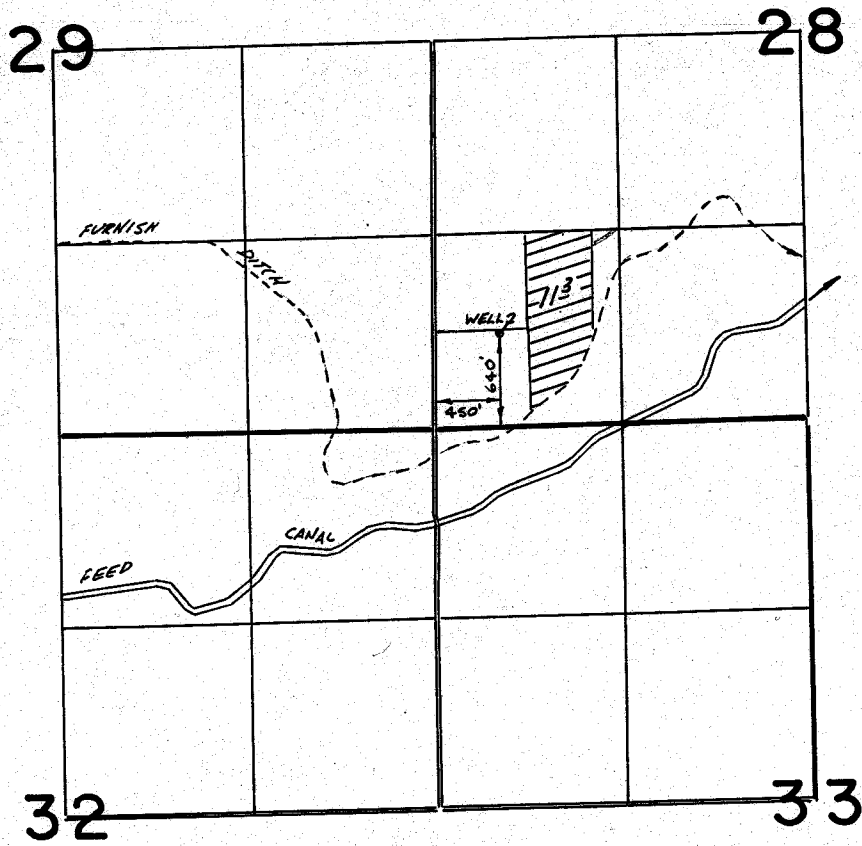

**FINAL PROOF SURVEY**  
UNDER

Application No. G:6534 Permit No. G:6142...  
IN NAME OF

ANDERSON LAND & LIVESTOCK...

Surveyed 6-19..... 1972., by Herbert L. Church.