


G-6630

53738

T. 5N. R. 29E. W.M.

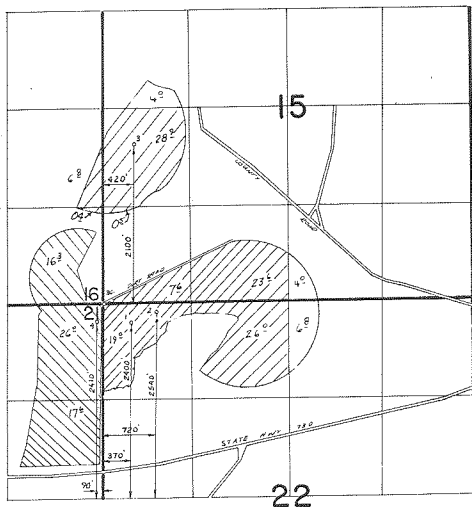

G-7200

G-7595

**FINAL PROOF SURVEY**  
UNDER

G-7595                      G-7143  
Application No. G-7200 Permit No. G-6630  
IN NAME OF

AL CONFORTH

Surveyed 7-5 1978, by R. BAEWIN  
2-13 79 R. BAEWIN

PL-7-23                      10-1-85  
NS-3MM-321                9-21-79  
PTS-1978-P-A                KC.