T. 6N., R. 36E., W.M.

Well Location: 2640' S. & 1950' E. from NW Cor. Sec. 29

PERMIT G-6341

PERMIT G-8090

PERMIT G-7511

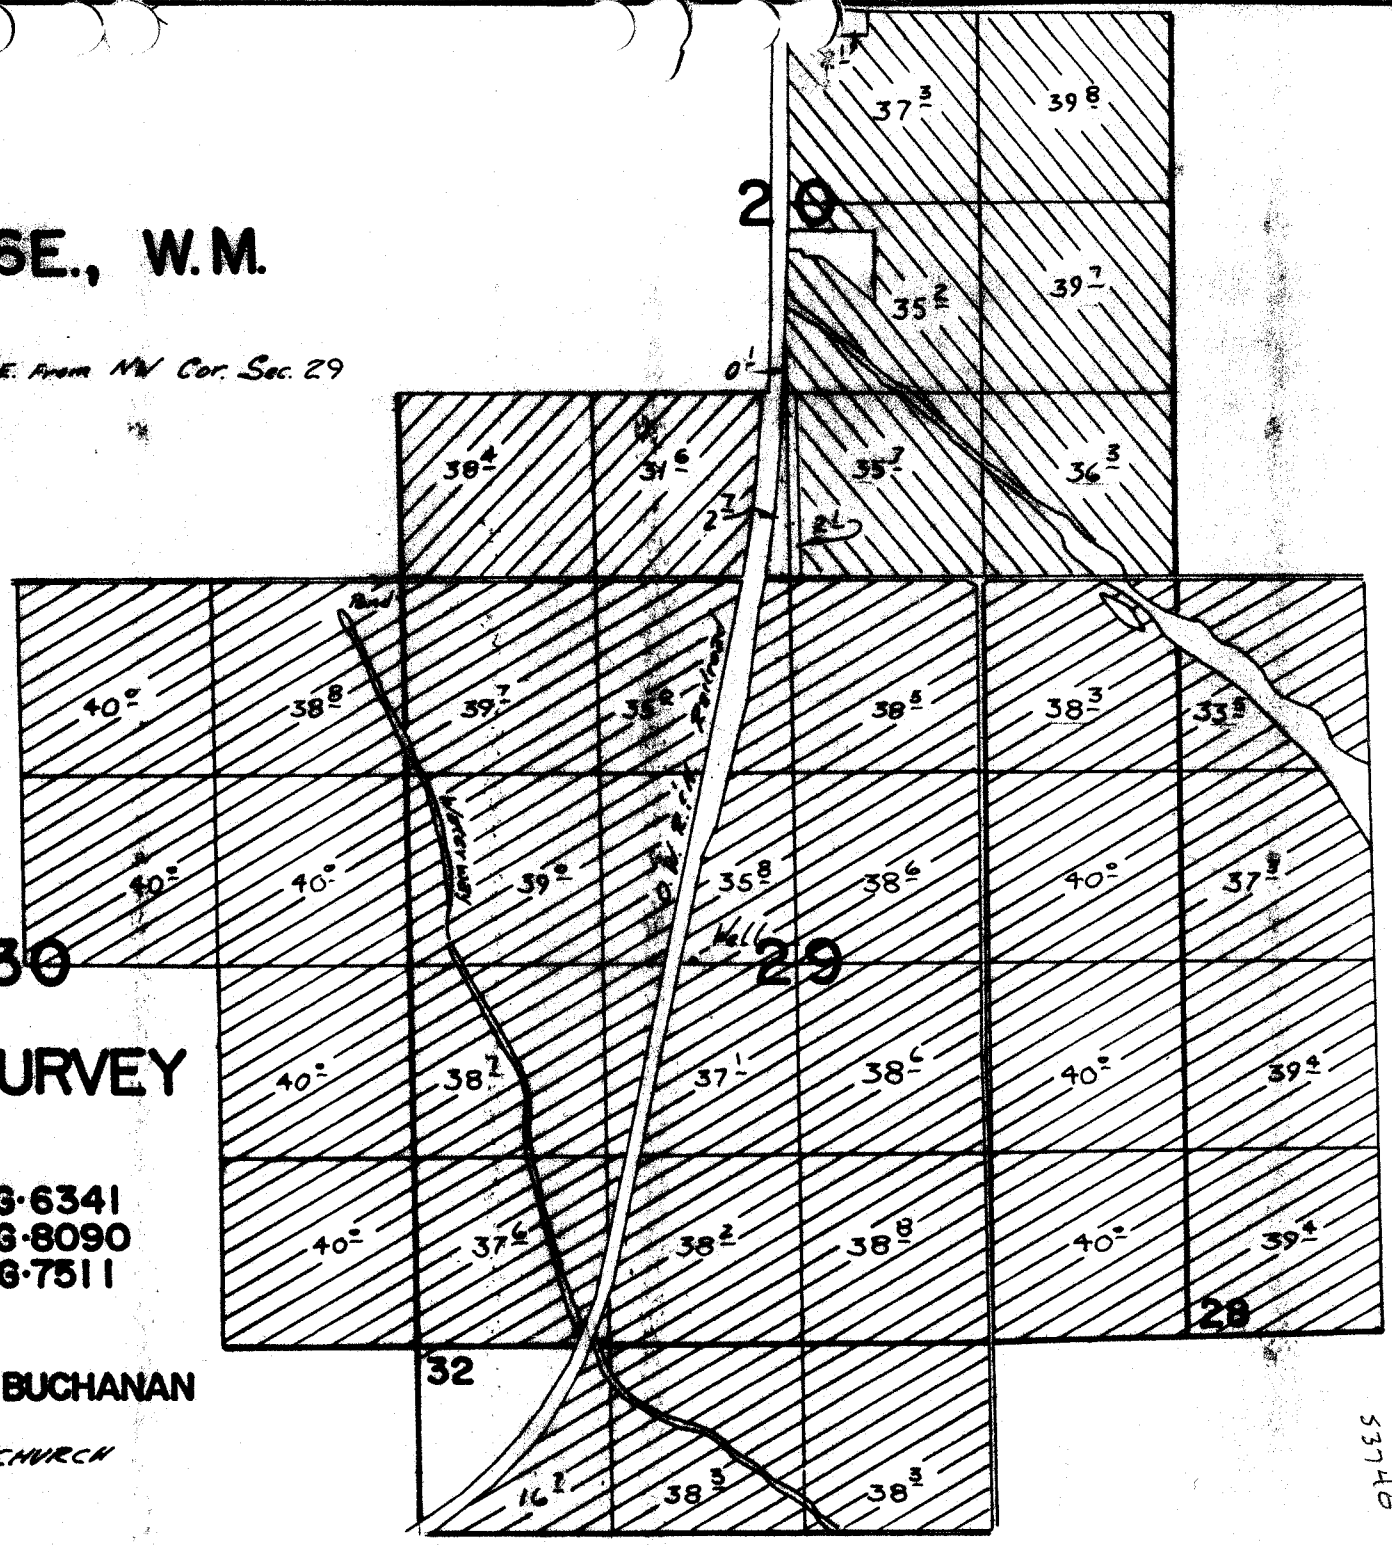

FINAL PROOF SURVEY

UNDER

APPL. G-7166, G-8661, G-8140

PER. G-6341, G-8090, G-7511

IN NAME OF

MARTIN H. & JANET A. BUCHANAN

Surveyed June 18, 1982 by V. CHURCH

G-6341

53740