


CANCELLED  

G-8590

65131  
53747

T. 2N., R. 32E., W.M.

See T-5981

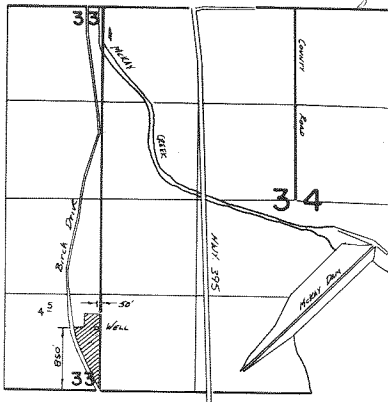

**FINAL PROOF SURVEY**  
UNDER

Application No. G-9244 Permit No. G-8590  
IN NAME OF

ROBERT D. WEEKS

Surveyed May 12 1988, by V. Church