


T. 2N., R. 32E., W.M.

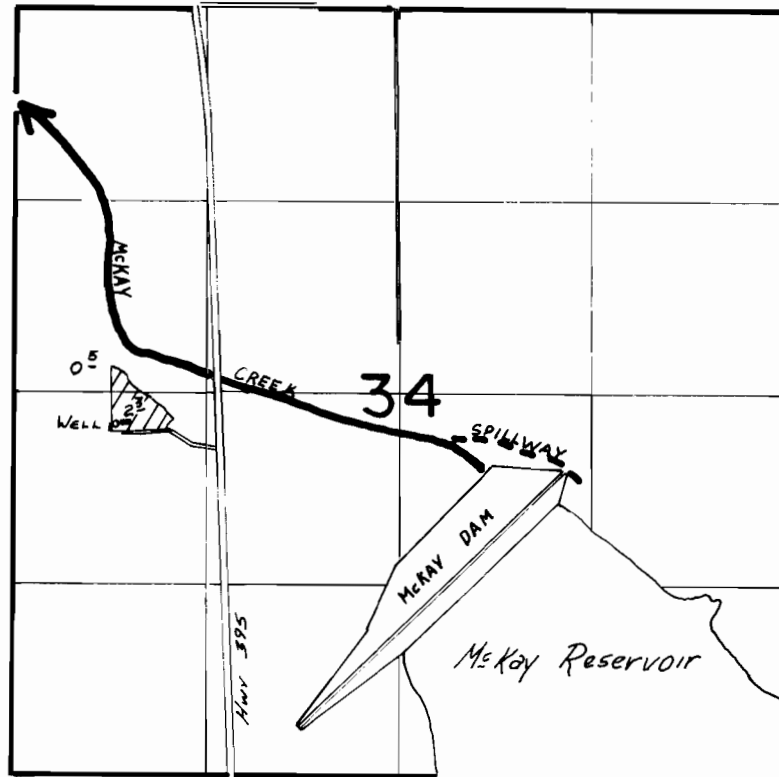

SCALE: 1" = 1320'



Well Loc: 220'S. & 720'E. FROM 1/4 SEC 34

FINAL PROOF SURVEY UNDER

Application No. **G:9350** Permit No. **G:8728**
IN NAME OF

ROBERT D. HALL

Surveyed *10-14* 19*83*, by *V.L. Church*