


G-8969

53749

T. 2N., R. 32E., W.M.

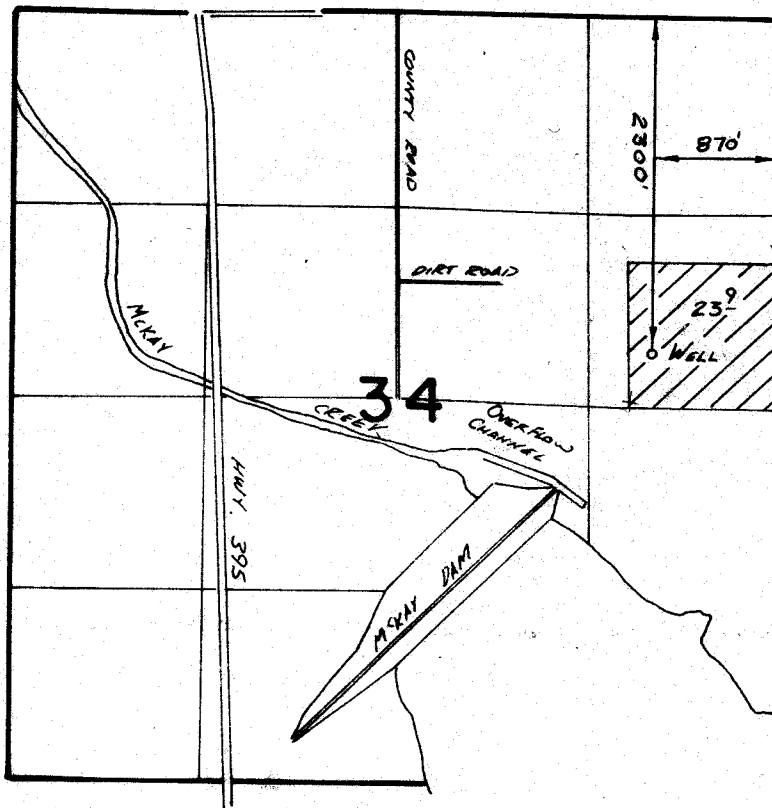

**FINAL PROOF SURVEY**  
UNDER

Application No. G-9808 Permit No. G-8969  
IN NAME OF

Charles Roger Montee

Surveyed May 12, 1982, by V. Church