
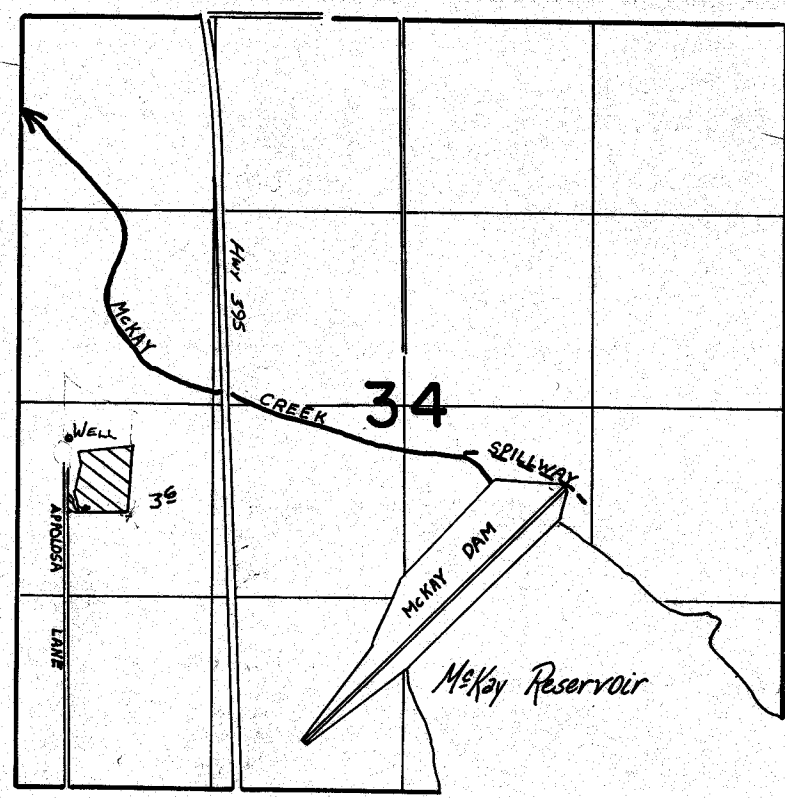


G-9550

53750

T. 2N., R. 32E., W. M.

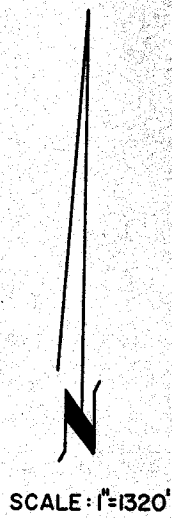

WELL LOCATED 2390' N. & 340' E. FROM SW COR. SEC 34

### FINAL PROOF SURVEY UNDER

Application No. G:9952 Permit No. G:9550...  
IN NAME OF

.....PATRICK C. DUNHAM.....

Surveyed ...5.25..... 1984., by V.L. Chasch.....