


T. 2S. R. 44E. W.M.

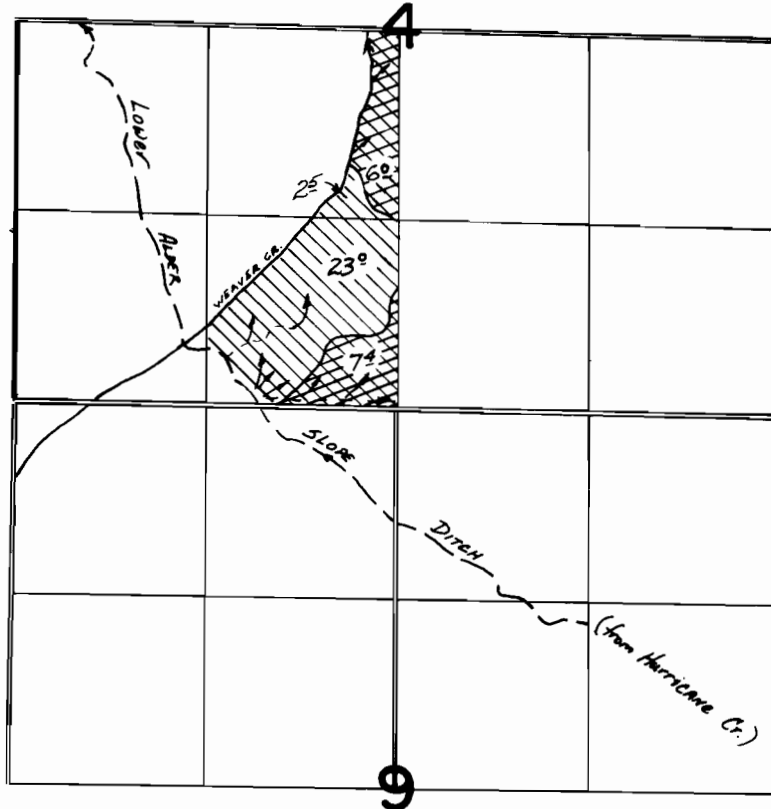

DIV. PT. LOC. S. 76° 02' W. 49' FROM THE NE COR.
OF SEC 3 T. 2S. R. 44E.

 - PRIMARY

 - SUPPLEMENTAL

FINAL PROOF SURVEY UNDER

Application No. 47142..... Permit No. 35295.....
IN NAME OF

..... DAVID P. PARKER

Surveyed 8-28..... 1978., by R. BARWIN.....