


T.182N. R.14E. W.M.

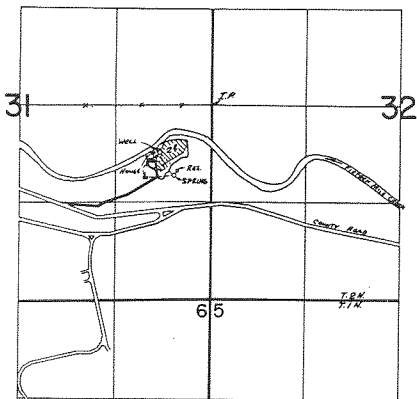

Well Loc. 660' S. & 720' W From The E 1/4 Cor. Sec. 31  
Spring Loc. 960' S & 530' W From The E 1/4 Cor. Sec. 31

**FINAL PROOF SURVEY**  
UNDER

G-8011                      G-7447  
Application No. 60541..... Permit No. 45293.....  
IN NAME OF

.....ARTHUR H. VanEATON.....

DEC. 11 1981  
Surveyed NOV. 6... 1981... by T. PAUL.....