G-7447

T.18&2N. R.14E. W.M.

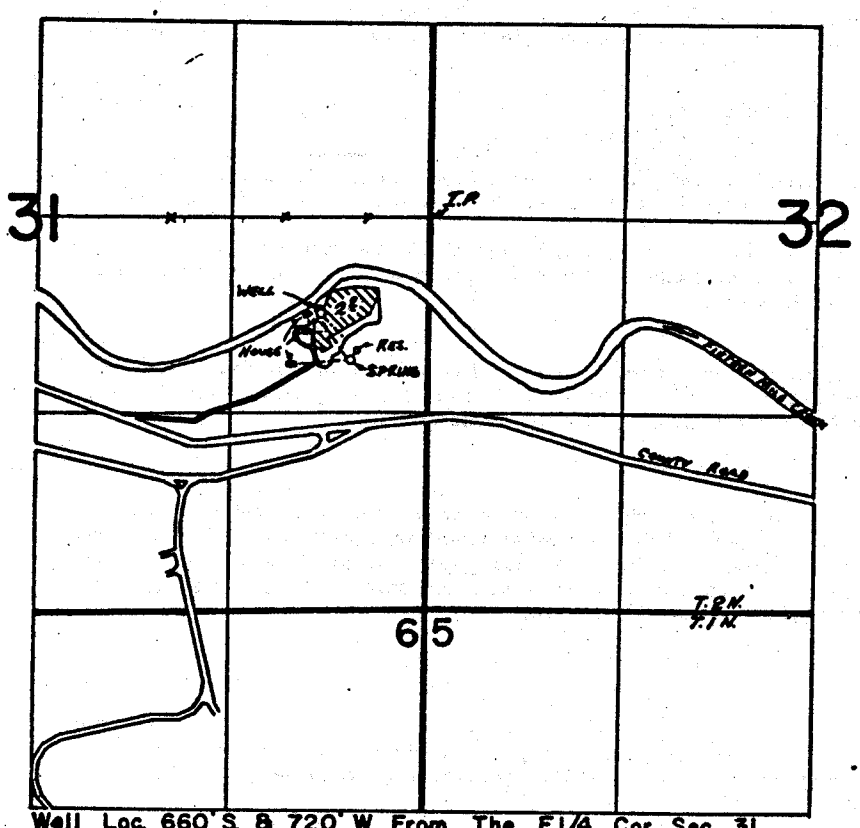

Well Loc. 660' S. & 720' W From The E1/4 Cor. Sec. 31
Spring Loc. 960' S & 530' W From The E 1/4 Cor Sec. 31

FINAL PROOF SURVEY
UNDER

Application No. G-8011 60541 Permit No. G-7447 45293
IN NAME OF

ARTHUR H. Van EATON

Surveyed NOV 6 DEC. 11 1981 19.81, by T. PAUL

WATERMASTER PHOTO 571-90