




P# 8931

T. 3 S. R. 12 E. W.M.

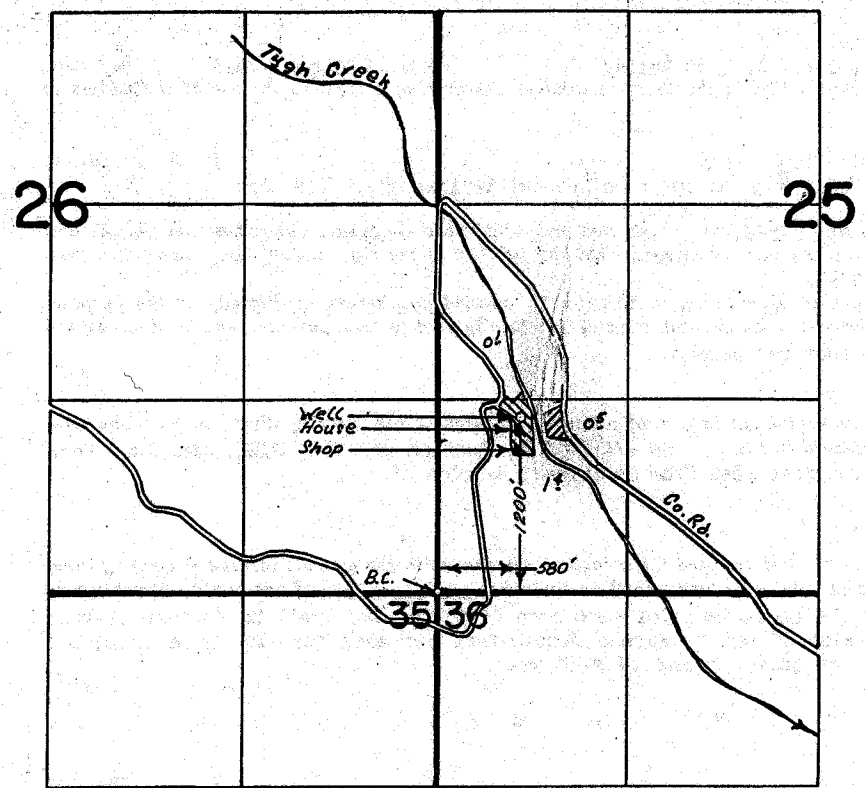

 Primary
 Supplemental

FINAL PROOF SURVEY UNDER

Application No. G-9293 Permit No. G-8931
IN NAME OF

VINCENT C. NEAL

Surveyed May 19, 1983, by T. J. Paul