


RECEIVED
MAR 20 1969
STATE ENGINEER
SALEM OREGON

RECEIVED
MAR 31 1969
STATE ENGINEER
SALEM OREGON

MAP OF WATER RIGHT - SCALE 1" = 300'
MARGARET M. & DOUGLAS W. GRASSICK
NE 1/4 NW 1/4 SEC. 21, T5N, R9W - CLATSOP COUNTY

SURVEYOR'S CERTIFICATE:

I, Wilbur A. Markham,
Registered Engineer No. 1942,
hereby certify that this map
is made from notes of an
actual survey made by me
on March 11, 1969.

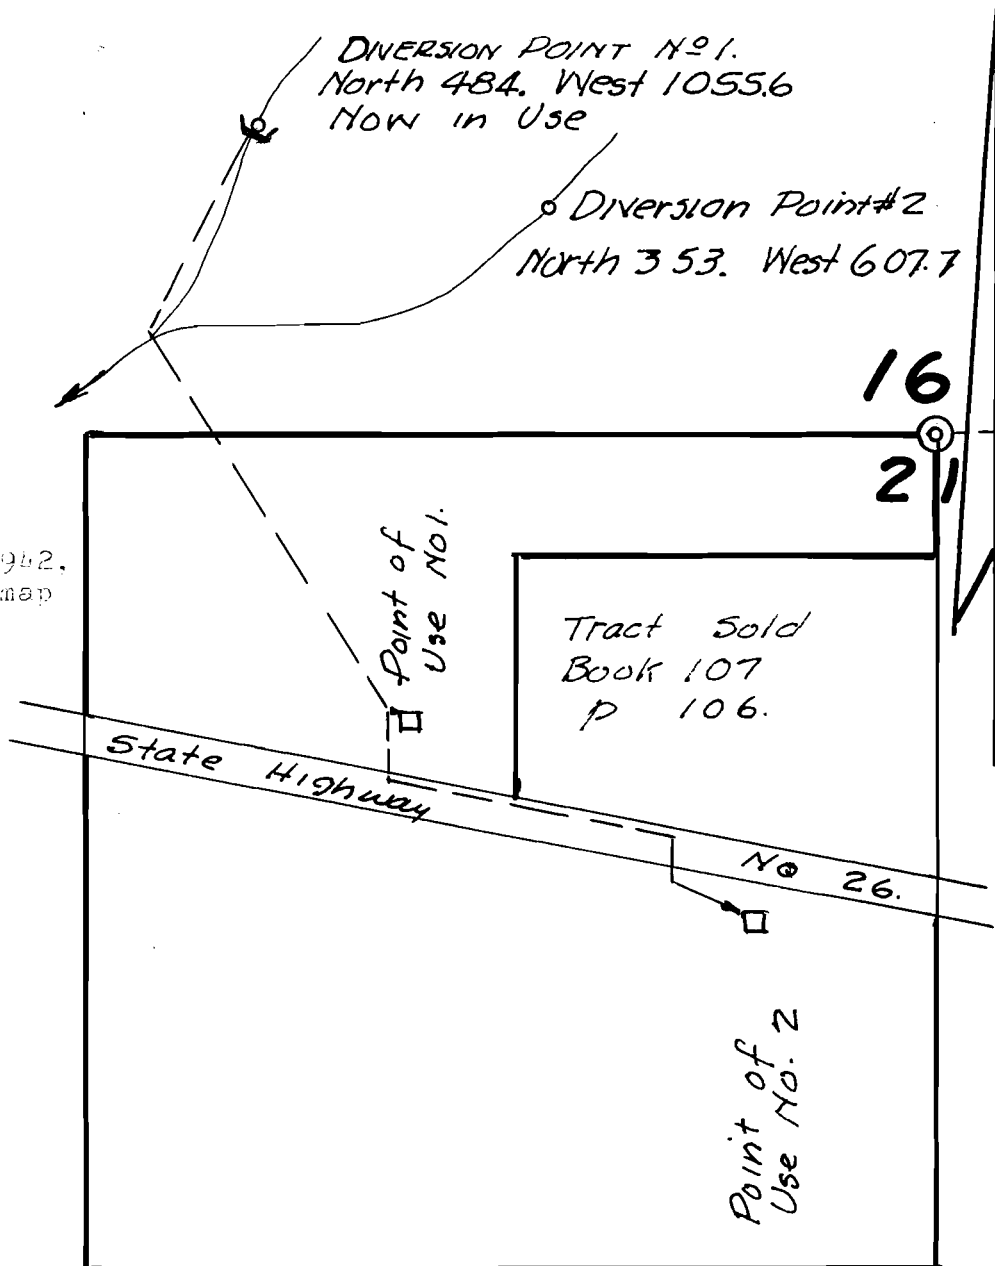

Application No. 45865
Permit No. 34242