


T.4N.R.5W.W.M.

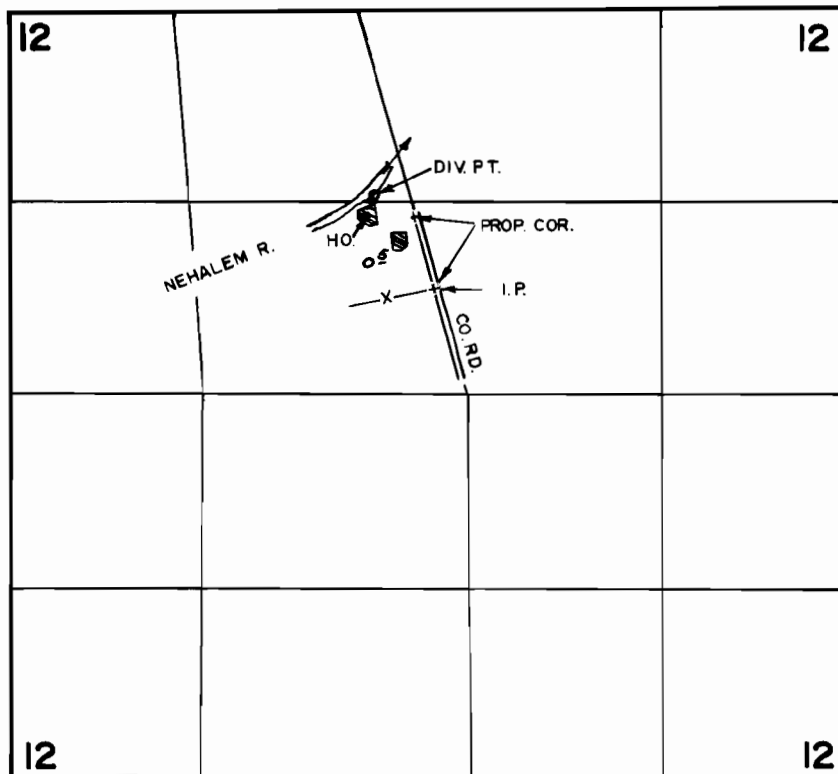

DIV. PT. LOC.: 1400' N. & 650' W. FROM CEN. SEC. 12

FINAL PROOF SURVEY
UNDER

Application No. 51580... Permit No. 37790.....
IN NAME OF

JOSEPH C. & BETTY V. BAUDOIN.....

Surveyed MAY. 20.. 1980., by R.G. MUCKEN.....