


T. 25S., R. 12W., W.M.

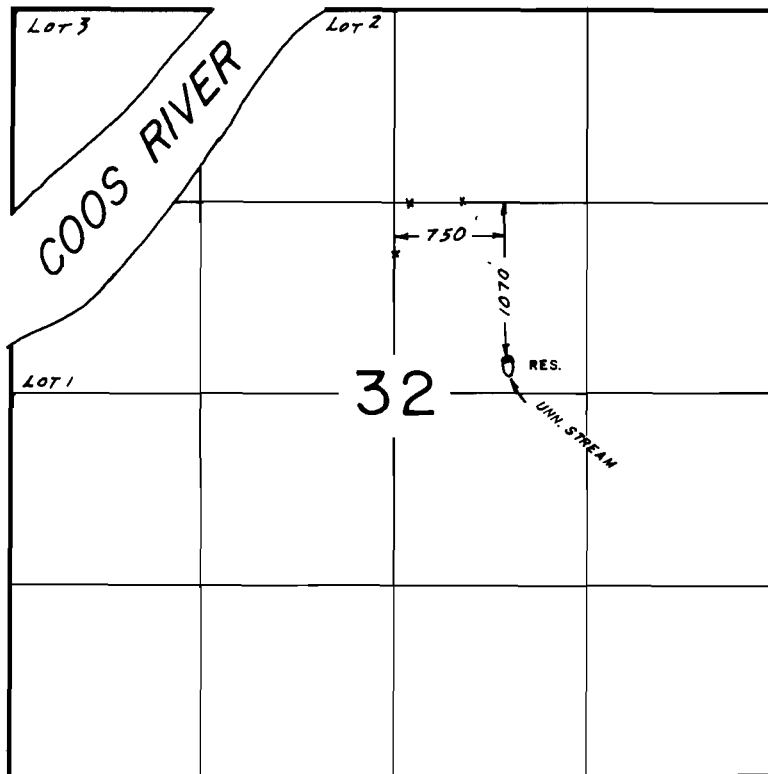

**FINAL PROOF SURVEY**  
UNDER

R-54350                      R-6492  
Application No. 54351... Permit No. 40688.....  
IN NAME OF

.....ALVIS E. CURL.....

Surveyed JUNE 16.. 1980., by J.S. DONALDSON