


RECEIVED

FEB 4 - 1986

WATER RESOURCES DEPT  
SALEM, OREGON

T.25S.,R.12W.,W.M.

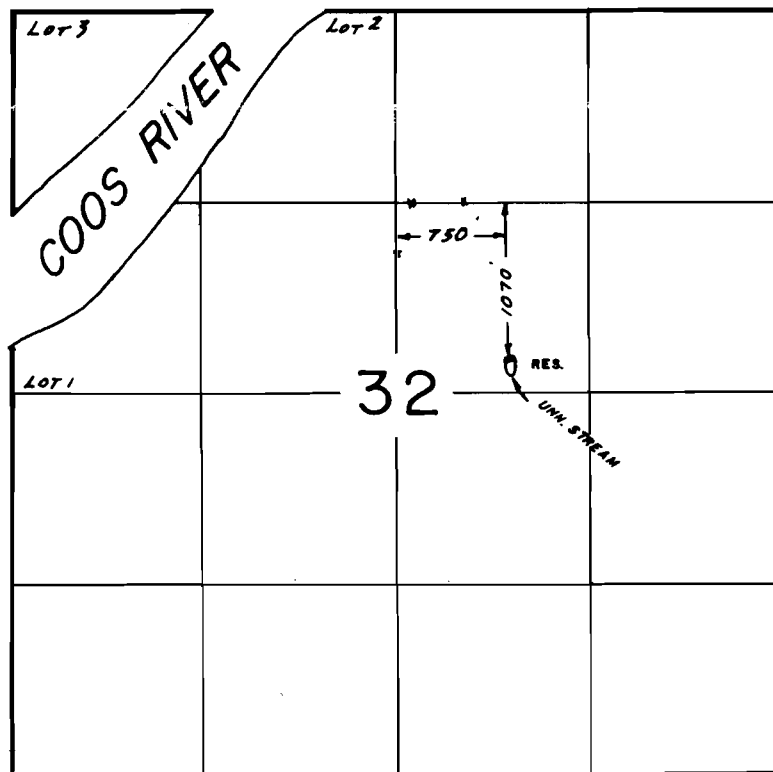

**FINAL PROOF SURVEY**  
UNDER

R-54350                      R-6492  
Application No. 54351... Permit No. 40688.....  
IN NAME OF

.....ALVIS E. CURL.....

Surveyed JUNE 16, 1980, by J.S. DONALDSON