


T.30S. R.11W. W.M.

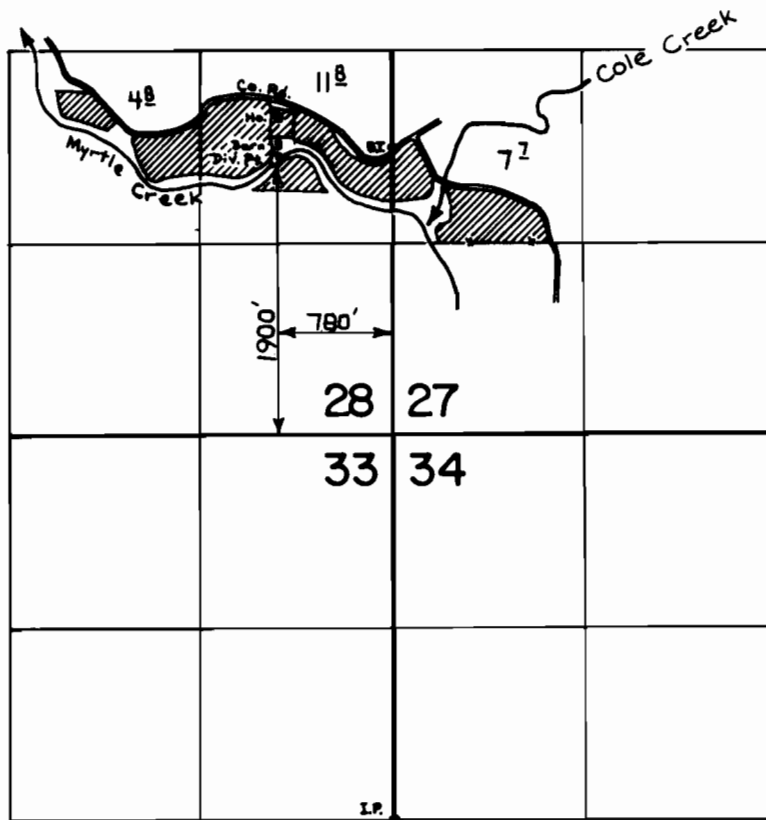

SCALE: 4" = 1 mile

FINAL PROOF SURVEY
UNDER

Application No. 47165 Permit No. 35310
IN NAME OF

EARL F. WATERMAN

Surveyed July 21, 1980, by S. Donaldson.....